

Name

Service No.

Address 80B Hancock Street

Location

Kind of Pipe

Size

Size of Main

Repair—Renewal—New Service

Location

Date	Material	Amount	Total	Date	Amount
8-5-53	54' 6" Sewer Pipe				
				6/11/86	
				11'5"	
				2	
					OUTSIDE
					6" PVC Pipe
					6" x 6" PVC Ferncos
					16 yds. gravel


TOWN OF LEXINGTON — BOARD OF PUBLIC WORKS

SEWER DIVISION

DATE _____

Sketch of Service Here

80 B

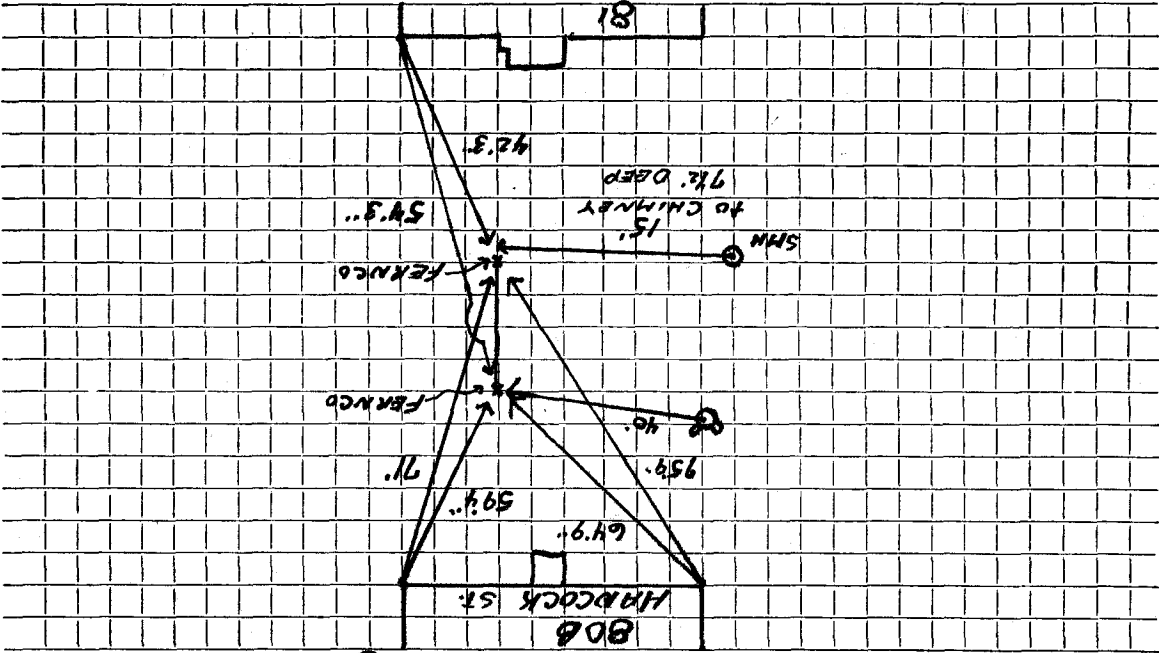

Connection made in Street. Work completed

Remarks: