


TOWN OF LEXINGTON — BOARD OF PUBLIC WORKS

SEWER DIVISION

DATE _____

83

Sketch of Service Here

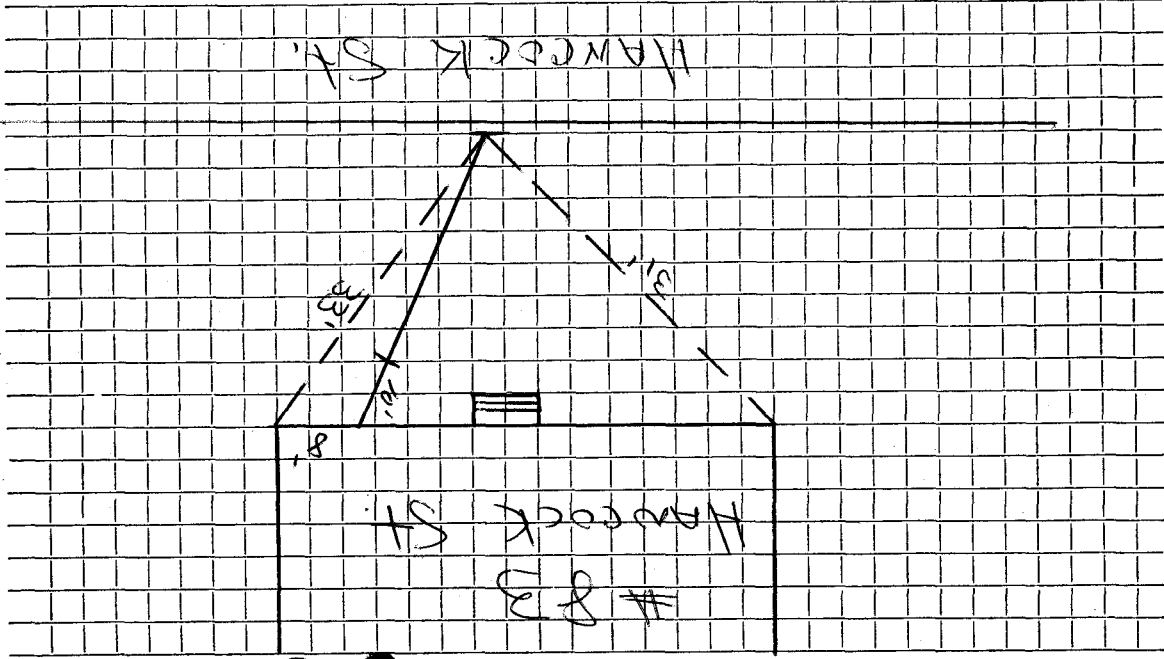

Work completed

Street.

Connection made in


Remarks:

DATE 12-4-2000

TOWN OF LEXINGTON — BOARD OF PUBLIC WORKS

SEWER DIVISION

Sketch of Service Here

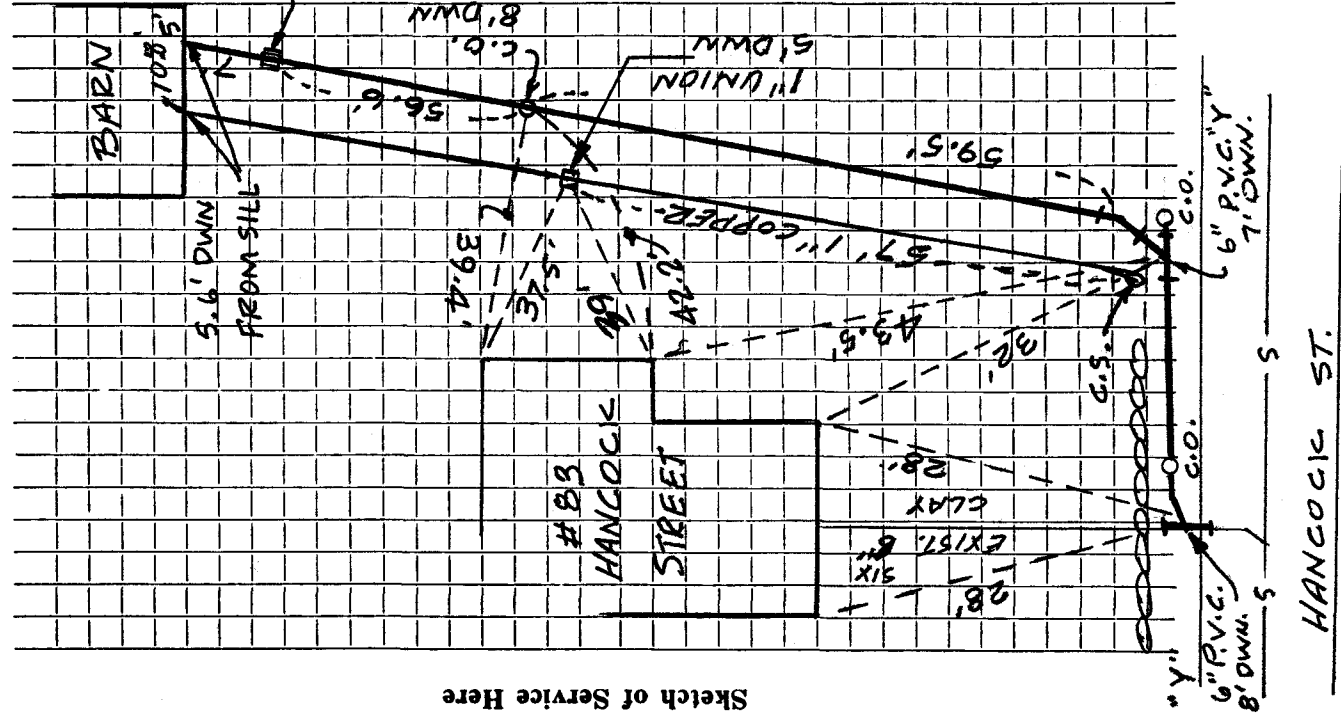

Connection made in HANCOCK ST. Street.
 Work completed by C.A. CARDILLO & SONS
 Remarks: TRENCH WITHIN RIGHT OF WAY WAS BACKFILLED WITH LOW DENSITY FILL.
 FERDINO 5.6'DWN.