

Name Thomas Tuck

Service No. 178

Address 84 Hancock Street

Lexington, Mass.

Kind of Pipe

Size of Main

~~Repair~~ ~~Renewal~~ New Service

Location

Com. 12-31-51

Date	Material	Amount	Total	Date	Amount
12/11/51	Labor	25 60		11-27-51	150 00
	10% overhead	2 56	28 16		Deposited The. Tuck do d
	56' -6" sewer pipe @ .342		19 15		(89 95
	1 -6" elbow		1 88		110 05
	joint compound		3 36		
	6 hrs. Littlefield shovel @ 7.		42 00		
	2 hrs. trucking		1 50		
	patching 14 x 3		14 00		
			110 05		
	Labor				

TOWN OF LEXINGTON—DEPT. OF PUBLIC WORKS

SEWER DIVISION

DATE ..... NO. ....


The undersigned applies for the construction of a particular sewer connecting No. .... Street and hereby agrees to comply with the Rules and Regulations governing the construction and use of Particular Sewers, as now or at any future time established by the Board of Selectmen.

Am't of estimate \$.....

Am't Paid \$.....

Owner .....

Sketch of Service Here

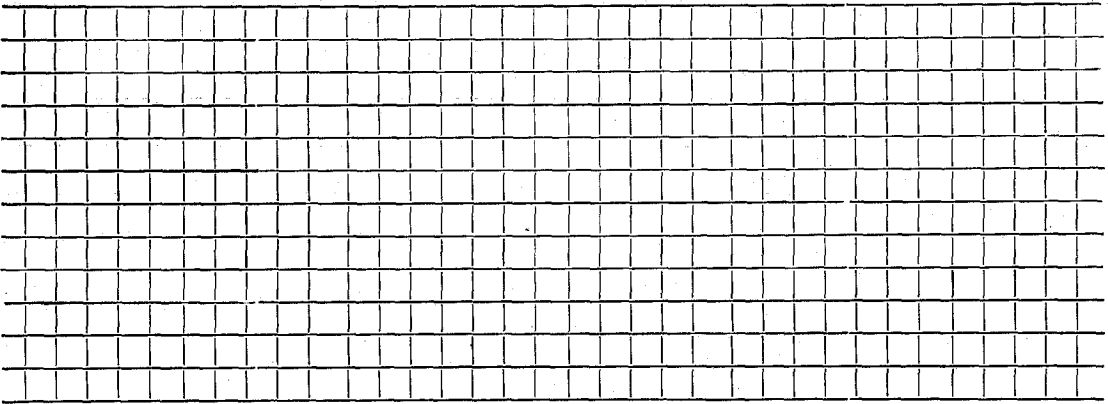

Connection made in ..... Street. Work completed ..... 19..

Remarks: