




TOWN OF LEXINGTON — BOARD OF PUBLIC WORKS

SEWER DIVISION

Sketch of Service Here

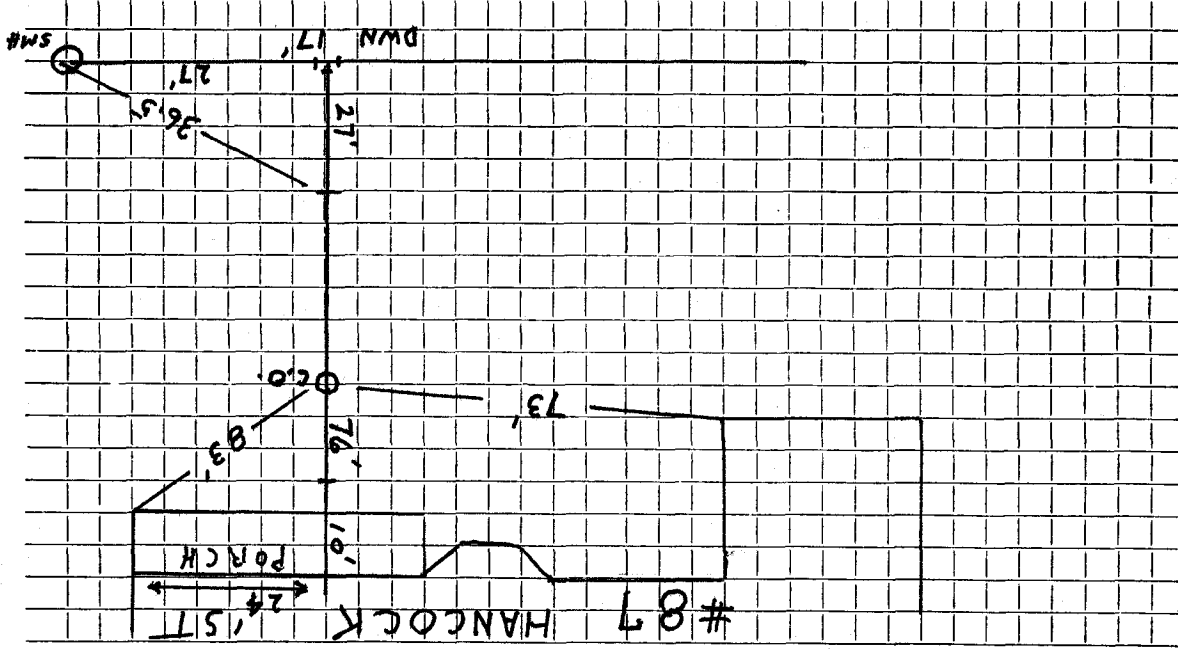

Connection made in HANCOCK ST Down 17' Street.

Work completed

Remarks: Sewer & water 5ams. Traced in ST.

DATE