

Name Craig Hill

Service No. 22

Address 87 Hancock Street

Location

Kind of Pipe Size of Main

~~XXXXXXXXXXXX~~ New Service Location

Date	Material	Amount	Total	Date	Amount
4-12-58	Labor	80.57		2-22-58	1.50
	10% overhead	8.06	88.63	5-4-58	5.22
30'	6" Transite pipe @.70		21.00	5-4-58	1.55
6'	6" Clay Pipe @.435		2.61		
1	6" Clay Elbow		1.88		
1	1 1/2" Transite Bend		5.10		
15	x 3 Patch		15.00		
3	hrs. Town Shovel @ 6.50		19.50		
2	hrs. Trucking @.75		1.50		
			155.22		
	Labor				

TOWN OF LEXINGTON—DEPT. OF PUBLIC WORKS

SEWER DIVISION

DATE.....

The undersigned applies for the construction of a particular sewer connecting No.....


Street and hereby agrees to comply with the Rules and Regulations governing the construction and use of Particular Sewers, as now or at any future time established by the Board of Selectmen.

Am't of estimate \$.....

Am't Paid \$.....

Owner.....

Sketch of Service Here

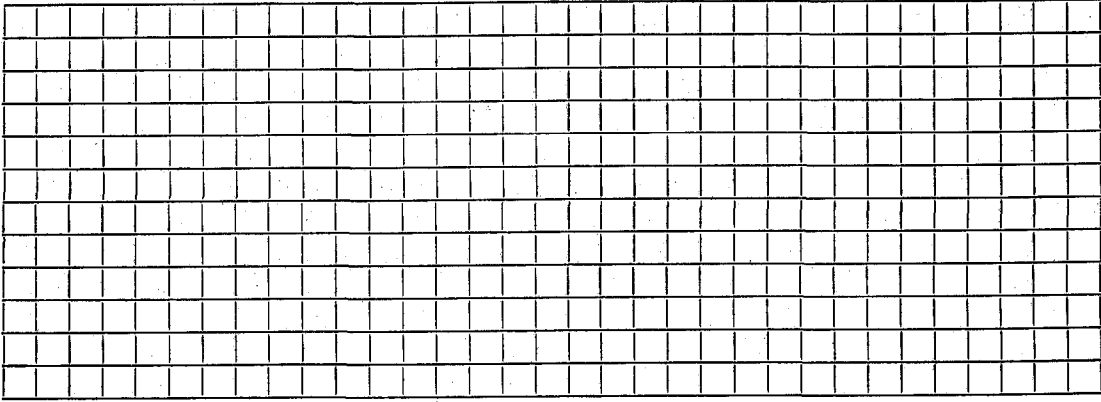

Connection made in..... Street. Work completed..... 19..

Remarks: