

Name Custance Brothers

Address 88 Hancock Street

Lexington, Mass.

Location 88 Hancock Street

Size of Main

Kind of Pipe

Size

Location

Repair-Remarks-New Service

Amount

Date	Material	Amount	Total	Date	Amount
Jul. 14, '48	Labor	62 87			
15	"	32 62	95 49	Sub 12 '49	209 60
	10% Overhead		9 55		
	8 1/4" - 6" Sewer Pipe @ .20		21 84		
	1 - 6" 1/4 Bend		1 18		
	Joint Compound		5 04		
	Littlefield Shovel 8 hrs. @ 7.00		56 00		
	D4 Tractor 2 hrs. @ 3.00		6 00		
	Trucking 2 hrs. @ .75		1 50		
	Patching 13 x 3		13 00		
			209 60		
	Labor				
	<i>Sub 12 '49</i>				

TOWN OF LEXINGTON—DEPT. OF PUBLIC WORKS

SEWER DIVISION

DATE ..... NO. ....


The undersigned applies for the construction of a particular sewer connecting No. .... Street and hereby agrees to comply with the Rules and Regulations governing the construction and use of Particular Sewers, as now or at any future time established by the Board of Selectmen.

Am't of estimate \$.....

Am't Paid \$.....

Owner .....

Sketch of Service Here

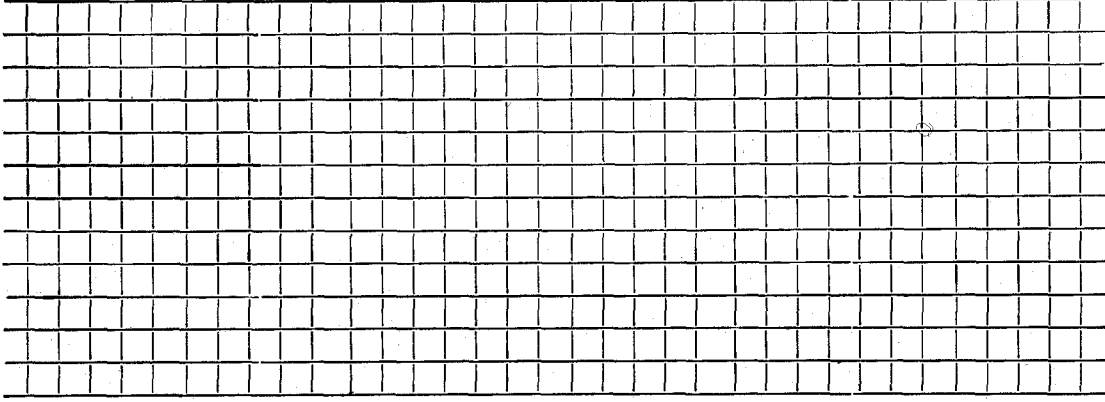

Connection made in ..... Street. Work completed ..... 19..

Remarks: