

Name Robert A. Proctor

Service No. 5 1010

Address 92 Hancock Street

Lexington 73, Mass.

Location 92 Hancock Street

Kind of Pipe

Size

Size of Main

Repair - ~~Renovate~~ - New Service

Location

Date	Material	Amount	Total	Date	Amount
May 4, '45	Labor	16 80		May 4, '45	110 00
May 5, '45	"	50 76	67 56	May 14, '45	6 80
	10% Overhead		6 76		103 20
	42' - 6" Sewer Pipe @ .22		9 24		
	10' - 4" Soil Pipe @ .50		5 00		
	Joint Compound		2 64	Bill sent 5-14-45	
	Compressor 1 hr. @ 1.75		1 75		
	Trucking 3 hrs. @ .75		2 25		
	Patching 12 x 3		8 00	Respond + Measure (SR)	
			103 20		103 20
	Labor				

TOWN OF LEXINGTON—DEPT. OF PUBLIC WORKS

SEWER DIVISION


DATE NO.

The undersigned applies for the construction of a particular sewer connecting No. Street and hereby agrees to comply with the Rules and Regulations governing the construction and use of Particular Sewers, as now or at any future time established by the Board of Selectmen.

Am't of estimate \$
 Am't Paid \$

Owner

Sketch of Service Here **92**

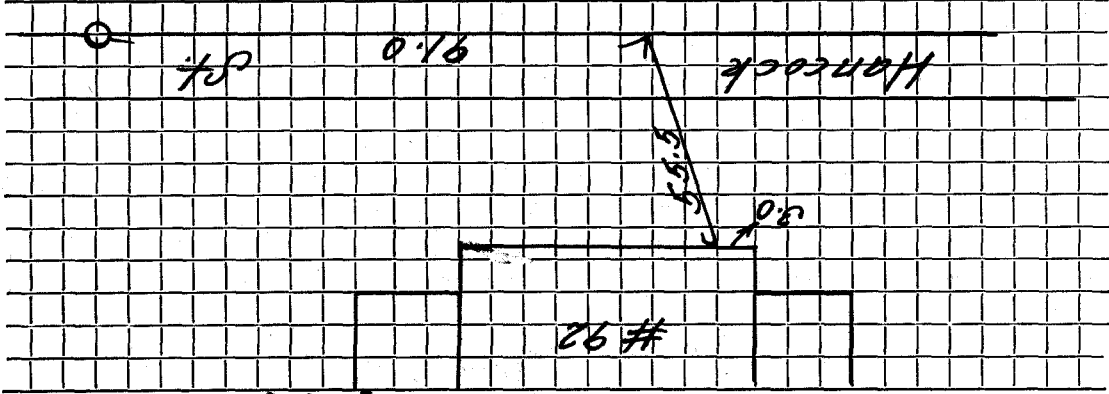

Connection made in Street. Work completed 19..

Remarks: