

Name John H. Millican

Service No. 134

Address 93 Hancock Street

Lexington, Mass.

Location 93 Hancock St.

Kind of Pipe

Size

Size of Main

~~Repairs~~ ~~Reconnect~~ - New Service

Location

Date	Material	Amount	Total	Date	Amount
Dec. 14, '48	Labor	21 80	21 80	Dec. 19 '48	110 00
" 15 "	"	10 66	10 66	Dec. 31 '48	8 51
	10% Overhead		3 25		101 49
	104'-6" Sewer Pipe @ .26		27 04		
	Joint Compound		6 24		
	3 hrs. Littlefield Shovel		21 00		
	2 hrs. Trucking		1 50		
	Patching 10 x 3		10 00		
			<u>101 49</u>		
	Labor				

TOWN OF LEXINGTON—DEPT. OF PUBLIC WORKS

SEWER DIVISION

DATE NO.


The undersigned applies for the construction of a particular sewer connecting No.
Street and hereby agrees to comply with the Rules and Regulations governing the construction and use of Particular
Sewers, as now or at any future time established by the Board of Selectmen.

Am't of estimate \$.....

Am't Paid \$.....

Owner

Sketch of Service Here

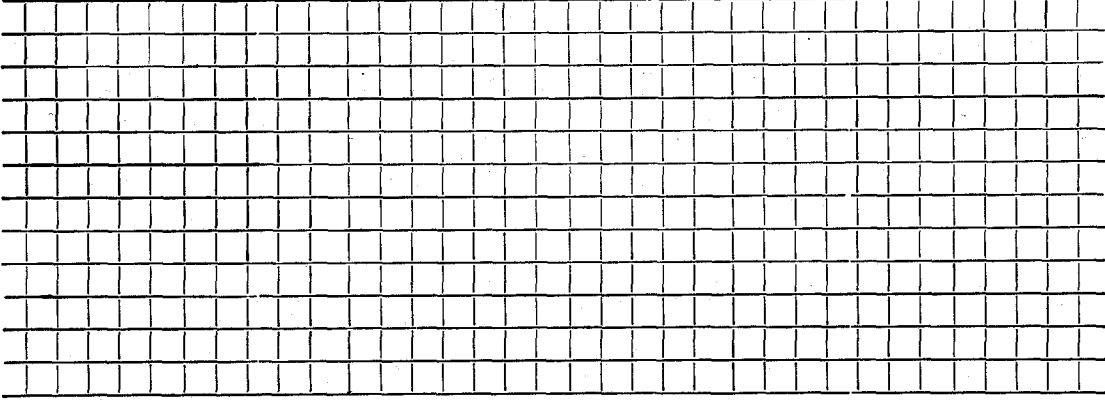

Connection made in Street.
Work completed 19..

Remarks: