

Name Kenneth Blodgett  
 Address 94 Hancock Street  
Lexington, Mass.

Service No. 10

Location 94 Hancock Street

Kind of Pipe Com. May 24, 1948

Size of Main

Size

~~REPAIR & RENEWAL~~ - New Service

Location

Date	Material	Amount	Total	Date	Amount
Mar. 30, '48	Labor	30 20		Mar. 22 '48	125 20
31	"	17 48	47 68	May 22 '48	14 61
	10% Overhead		4 77		110 39
	1/2' - 6" Sewer Pipe @ .26		10 92		
	Joint Compound		2 52		
	Littlefield Shovel 4 hrs. @ 7.00		28 00		
	Trucking 2 hrs. @ .75		1 50		
	Patching 15 x 3		15 00		
			110 39		
	Labor			5/27/48	solists - 10 ft. out
				3-13-48	S. B. 14' Dept

TOWN OF LEXINGTON—DEPT. OF PUBLIC WORKS

SEWER DIVISION

DATE ..... NO. ....


The undersigned applies for the construction of a particular sewer connecting No. ....  
Street and hereby agrees to comply with the Rules and Regulations governing the construction and use of Particular  
Sewers, as now or at any future time established by the Board of Selectmen.

Am't of estimate \$.....

Am't Paid \$.....

Owner .....

Sketch of Service Here

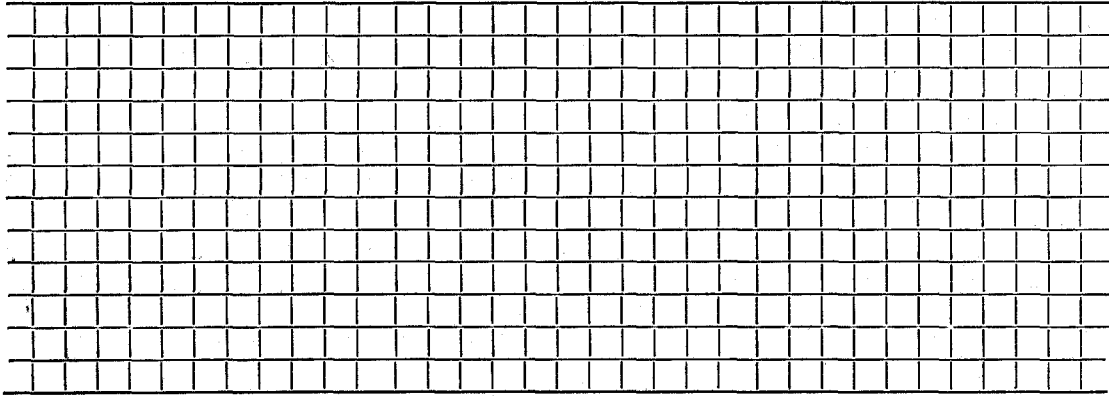

Connection made in ..... Street. Work completed ..... 19..

Remarks: