

Name Theima J. Willis

Service No. 136

Address 98 Hancock Street

Location

Kind of Pipe

Size

Size of Main

~~Repair~~ NEW SERVICE - COM. 12-13-54

Location

Date	Material	Amount	Total	Date	Amount
11/2/54	Labor	33 25		9-15-54	Deposited
	10% overhead	3 33	36 58	12-13-54	Refunded
	54' - 6" sewer pipe @ .32		17 28		NON CHARGE
	joint compound		3 24	11/2/54	Labor
	6 2/3 hrs. Littlefield shovel		58 88	14' - 6"	sewer pipe @ .32
	patching 18 x 3	7.50		joint compound	
	2 hrs. trucking @ .75		1 50	1 hr. Littlefield shovel	
			126 60	1 hr. trucking	
				patching 14 x 3	
					14 00
					38 65
	Labor			SEWER BEYOND CENTER OF STREET	

TOWN OF LEXINGTON—DEPT. OF PUBLIC WORKS

SEWER DIVISION


DATE NO.

The undersigned applies for the construction of a particular sewer connecting No. Street and hereby agrees to comply with the Rules and Regulations governing the construction and use of Particular Sewers, as now or at any future time established by the Board of Selectmen.

Am't of estimate \$.....
Am't Paid \$.....

Owner

Sketch of Service Here

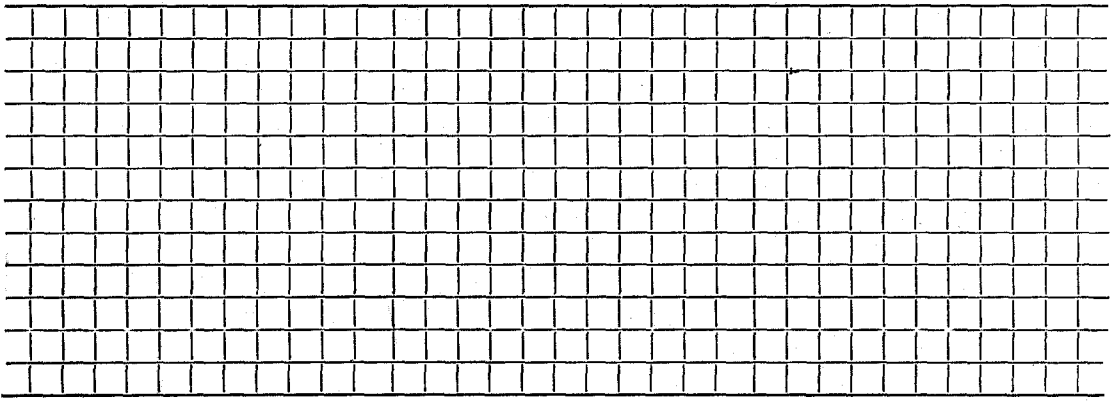

Connection made in Street. Work completed 19..

Remarks: