


TOWN OF LEXINGTON — BOARD OF PUBLIC WORKS

SEWER DIVISION

DATE _____

Sketch of Service Here

10

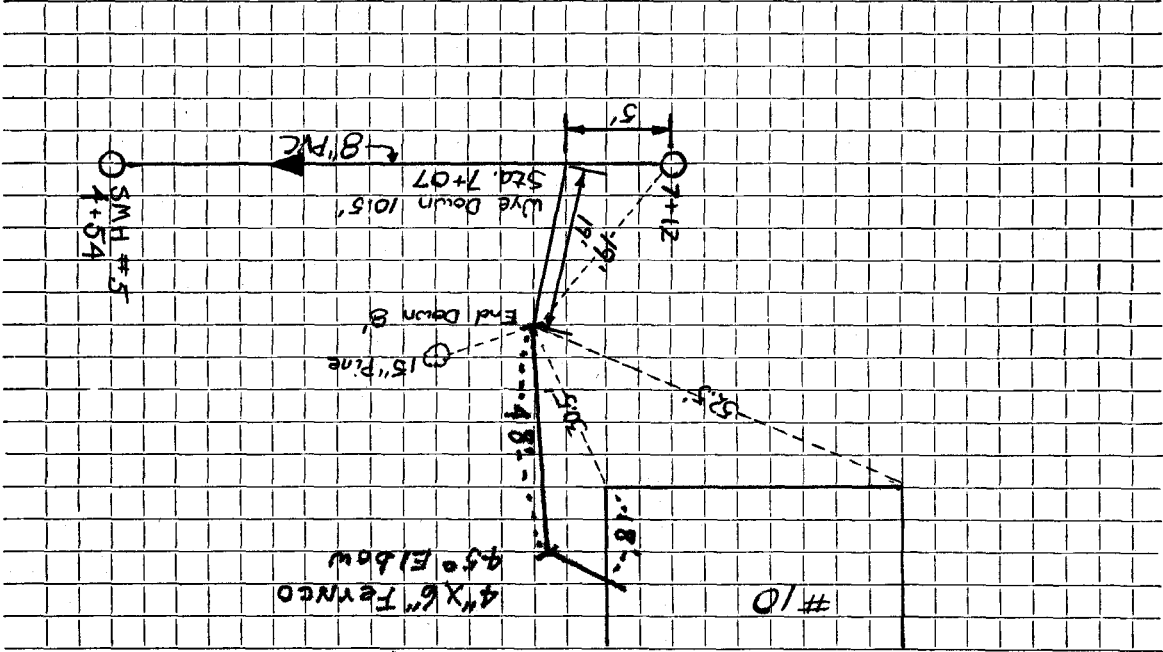

Connection made in HARBELL ST. Street. Work completed 12/15/82

Remarks: _____