




TOWN OF LEXINGTON — BOARD OF PUBLIC WORKS

SEWER DIVISION

DATE \_\_\_\_\_

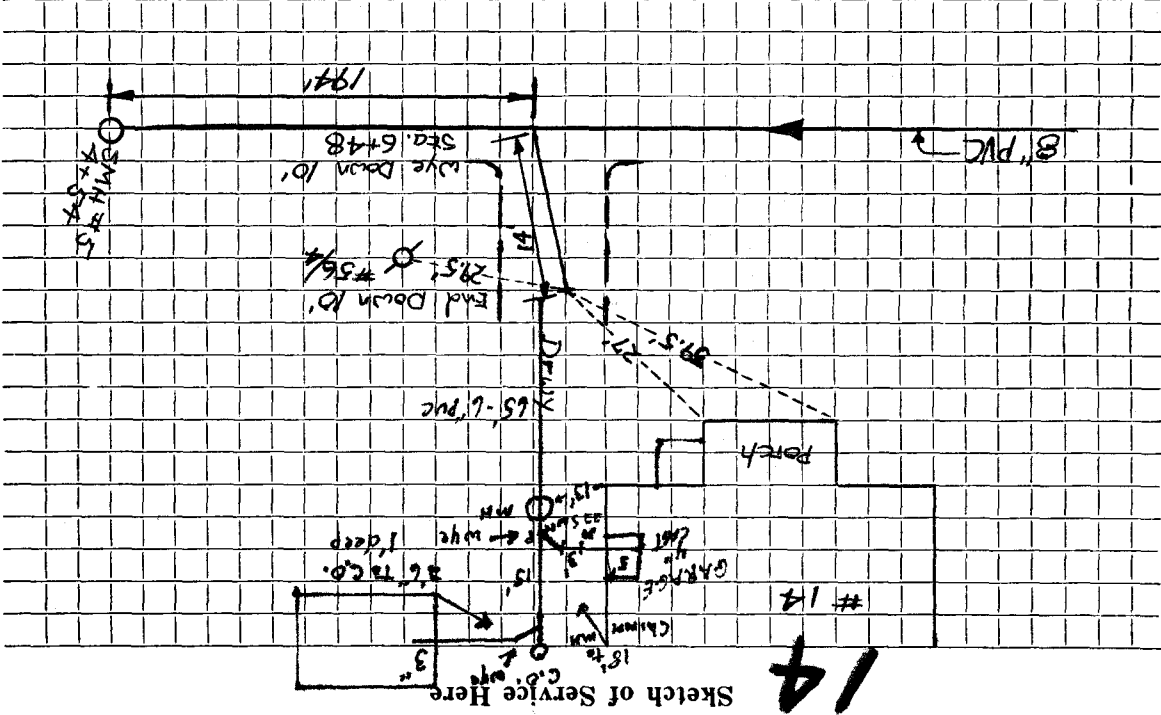

Connection made in HARBELL ST. Street.

Work completed. 12/14/02

Remarks: