


DATE _____

**TOWN OF LEXINGTON — BOARD OF PUBLIC WORKS
SEWER DIVISION**

Sketch of Service Here

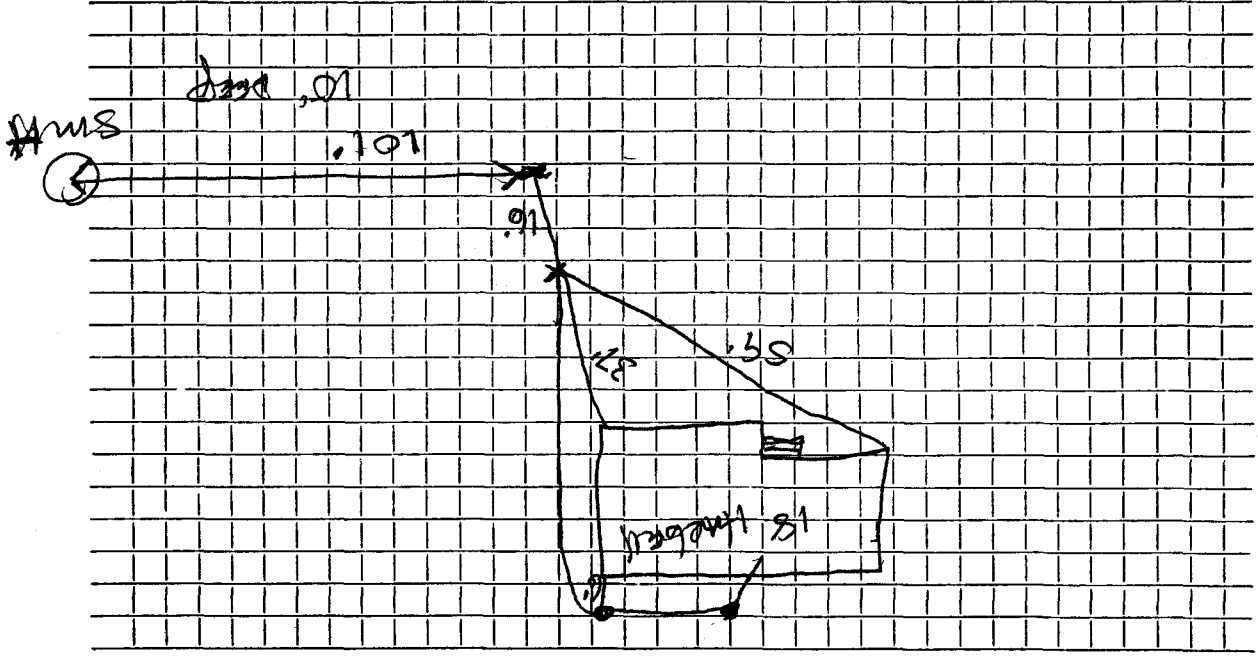

Connection made in Street. Work completed

Remarks: