




TOWN OF LEXINGTON — BOARD OF PUBLIC WORKS

SEWER DIVISION

DATE \_\_\_\_\_

Sketch of Service Here

21

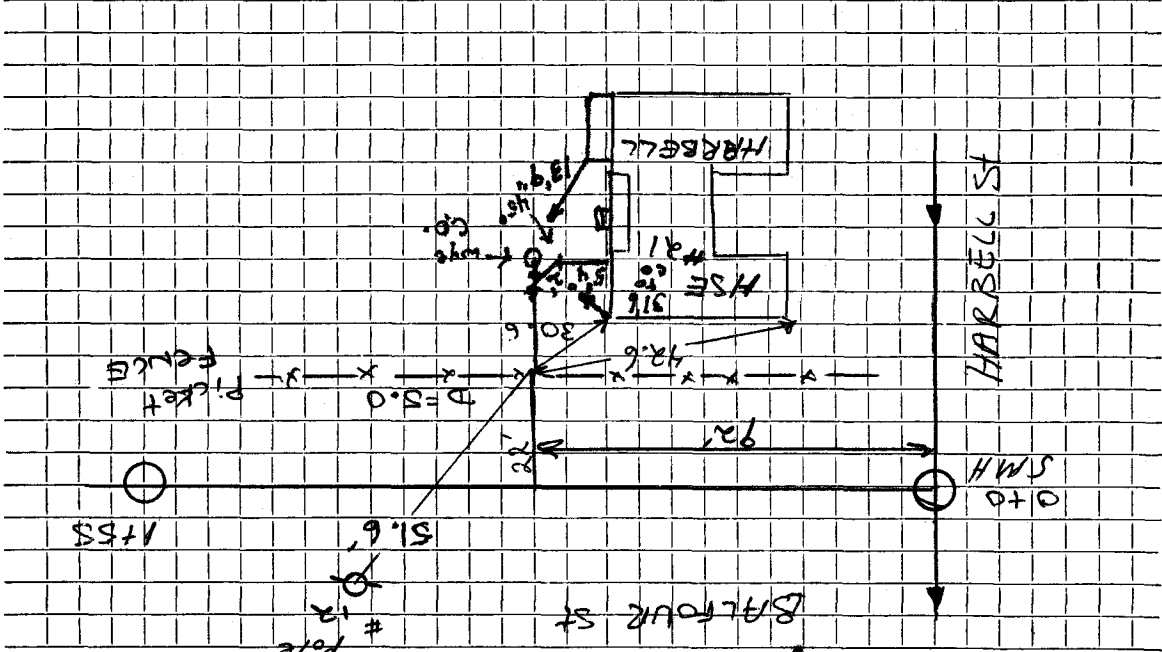

Connection made in *Balfour* Street.

Work completed

Remarks: *Clear out 8" straight out from house*