


TOWN OF LEXINGTON — BOARD OF PUBLIC WORKS

SEWER DIVISION

DATE _____

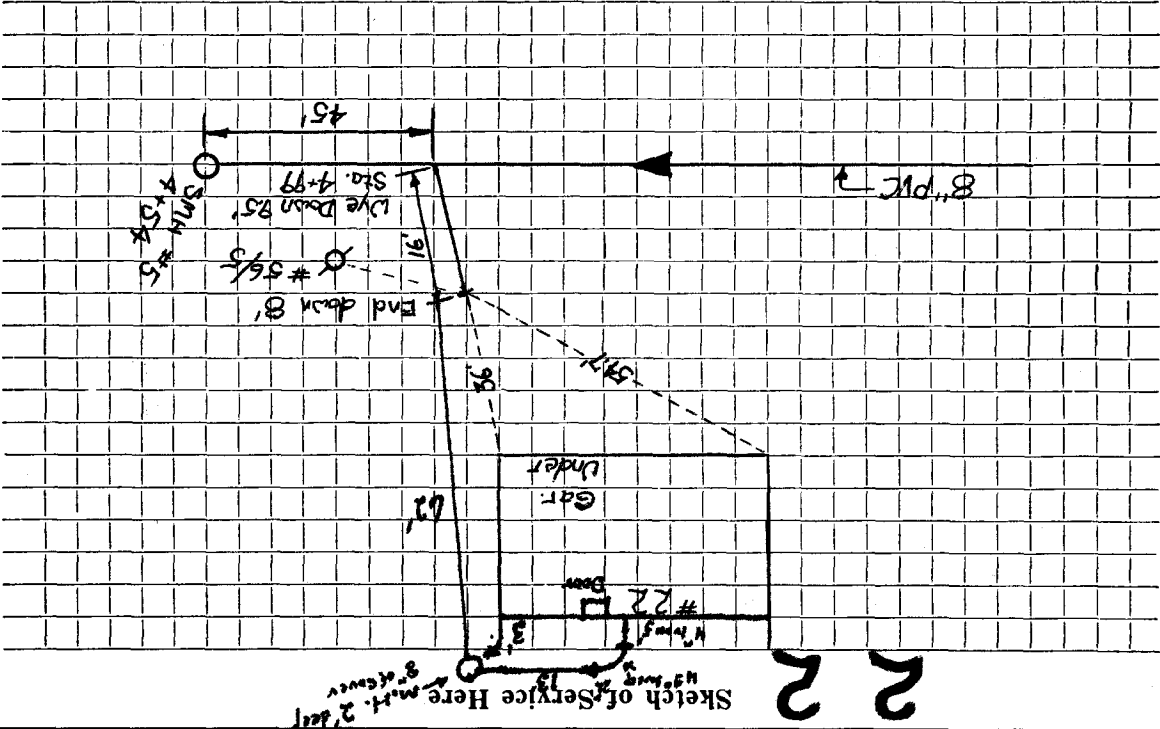

Connection made in **HARBELL ST.** Street. Work completed **12/14/82**

Remarks: