

TOWN OF LEXINGTON — BOARD OF PUBLIC WORKS


SEWER DIVISION

DATE _____

24

Sketch of Service Here SMH

SMH 5' OFF CORNER HOUSE

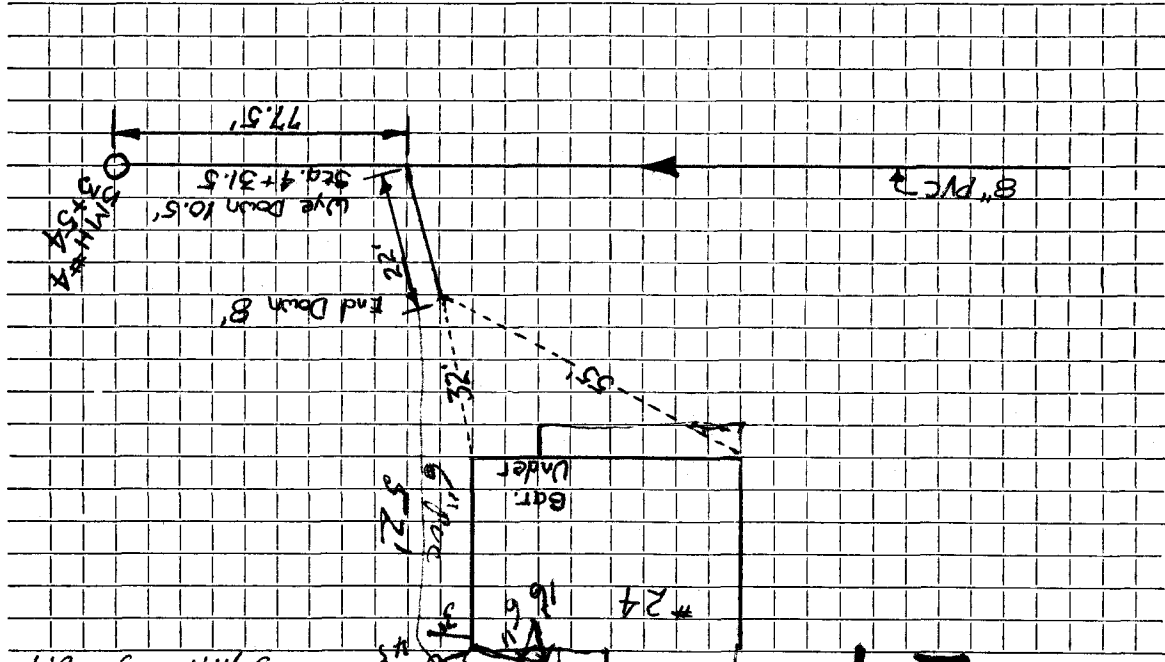

Connection made in HARDELL ST. Street. Work completed 12/14/82

Remarks: