


DATE MAY 1983

TOWN OF LEXINGTON — BOARD OF PUBLIC WORKS

SEWER DIVISION

Sketch of Service Here
25

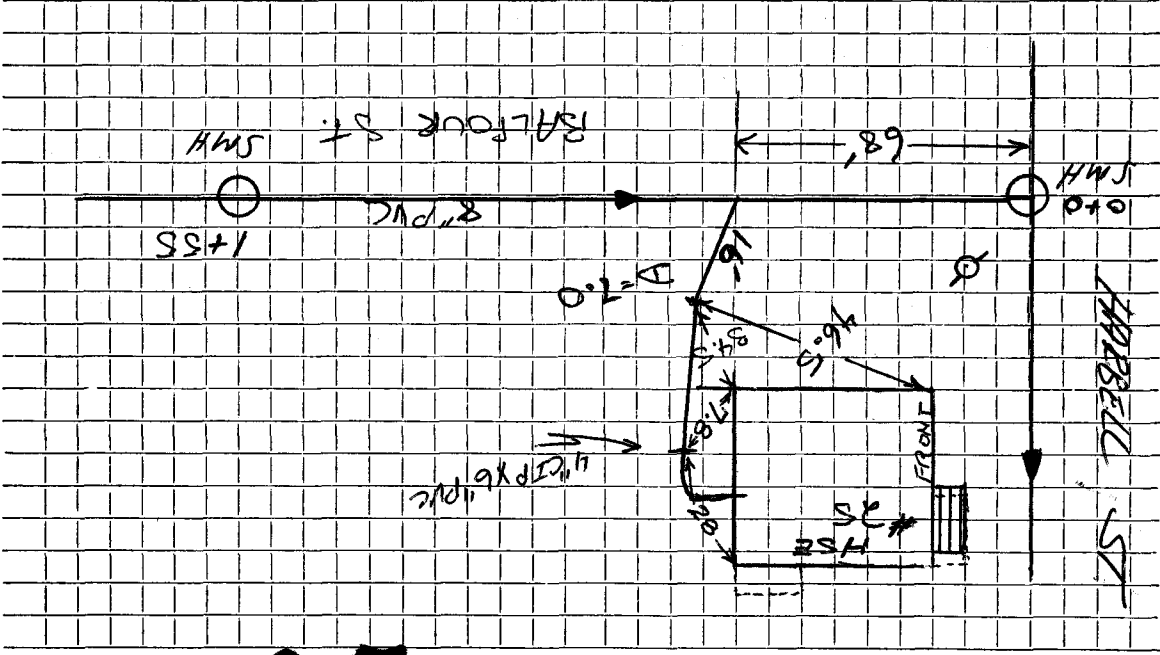

Connection made in Balfour Street.

Work completed. Dec 6, 1983

Remarks: