


TOWN OF LEXINGTON — BOARD OF PUBLIC WORKS

SEWER DIVISION

DATE _____

28

Sketch of Service Here

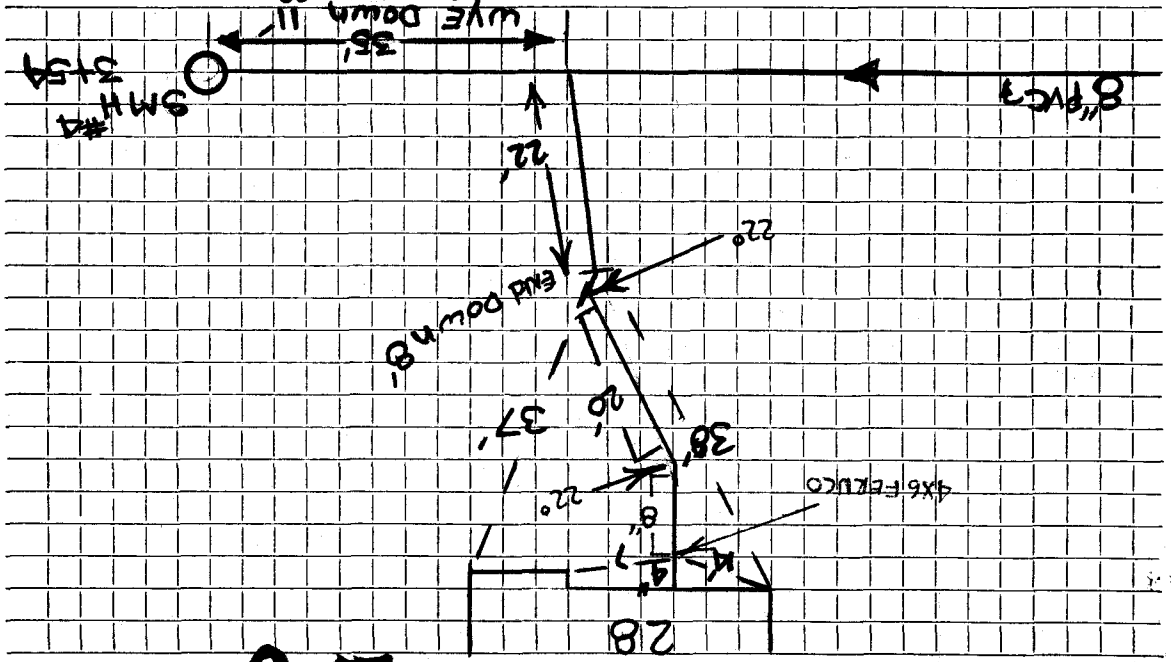

Connection made in HARBELL ST. Street.

Work completed

OUT SIDE. 12/14/82
IN SIDE. 12/26/84

Remarks: