

Name William Hamilton

Service No. 218

Address 6 Harbell Street

Location

Kind of Pipe

Size

Size of Main

Repair: ~~Renewal~~ - New Service

Location

11-24-58

Date	Material	Amount	Total	Date	Amount
8/9	Labor	42 81		11-17-58	110 10
	10% overhead	4 28		Deposit	
	64' 6" Transit Pipe @ .70		47 09		
	1 22 1/2 Bend Transit		44 80		
	1 Cesspool Cover & Frame		6 21		
	2 hrs. Trucking @ .75		10 50		
			1 50		
			110 10		
				4-28-98	Blockage 60' out Respond if necessary
	Labor				

**TOWN OF LEXINGTON—DEPT. OF PUBLIC WORKS
SEWER DIVISION**


DATE:.....
NO.

The undersigned applies for the construction of a particular sewer connecting No.....
Street and hereby agrees to comply with the Rules and Regulations governing the construction and use of Particular
Sewers, as now or at any future time established by the Board of Selectmen.

Am't of estimate \$.
Am't Paid \$.

Owner

Sketch of Service Here

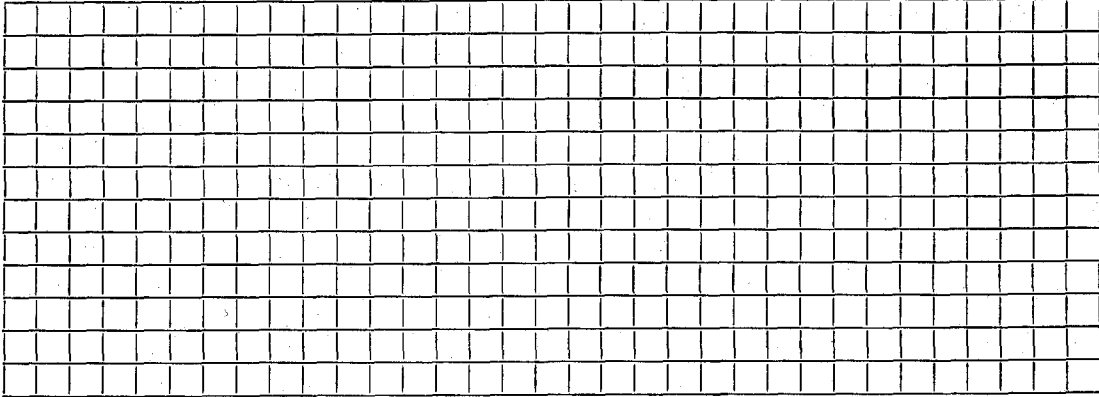

Connection made in..... Street.
Work completed..... 19..
Remarks: