


DATE 7/2018

TOWN OF LEXINGTON — BOARD OF PUBLIC WORKS
SEWER DIVISION

Sketch of Service Here

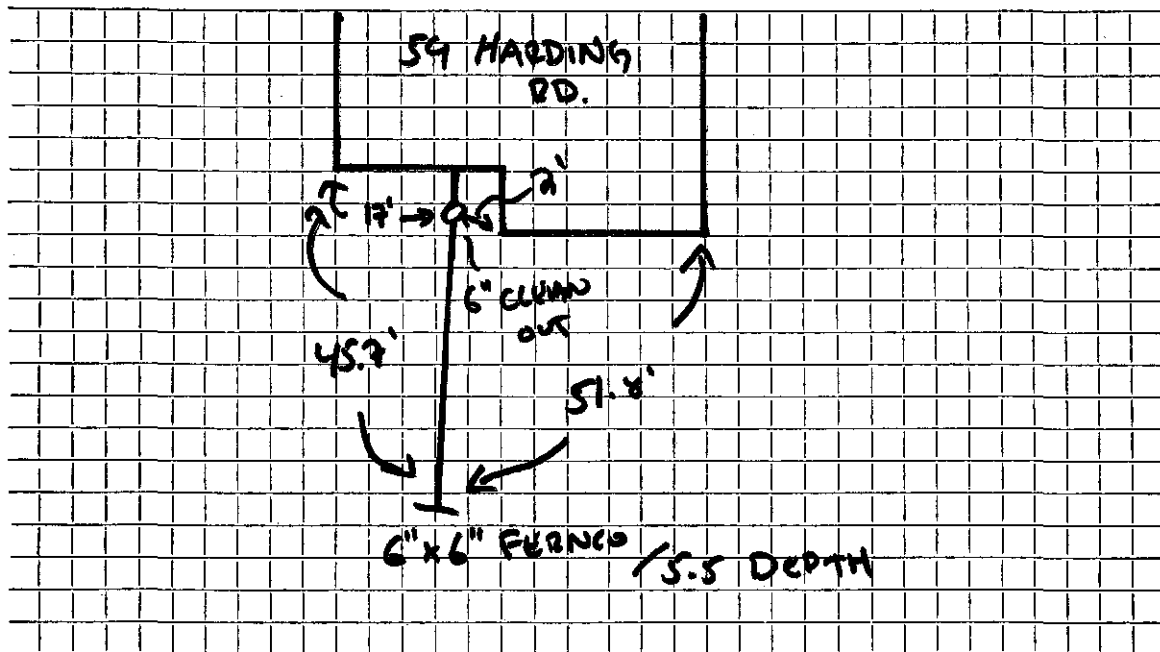

Connection made in HARDING Street. Work completed GYCON DEVELOPMENT

Remarks:

.....

.....