

Name John J. White Service No. 200

Address 12 Harding Road

Location

Kind of Pipe Size of Main

Size

~~Repair~~ New Service

Location Comm 2-26-62


Date	Material	Amount	Total	Date	Amount
11/10/61	Labor 55.61			12-26-62	250.00
1/10/62	" 81.54	137 15		2-26-62	3 63
	10% O.H.	13 72	150 87		253 63
67'	6" Transite Pipe @ .78		52 26		
1 Hr.	Trojan Loader @ 3.00		3 00		
5 Hrs.	Town Shovel @ 6.50		32 50		
4 Hrs.	Yrucking @ 3.00		12 00		
1 Hr.	Trucking @ 3.00		3 00		
			253 63		

DATE _____

TOWN OF LEXINGTON — BOARD OF PUBLIC WORKS

SEWER DIVISION

Sketch of Service Here

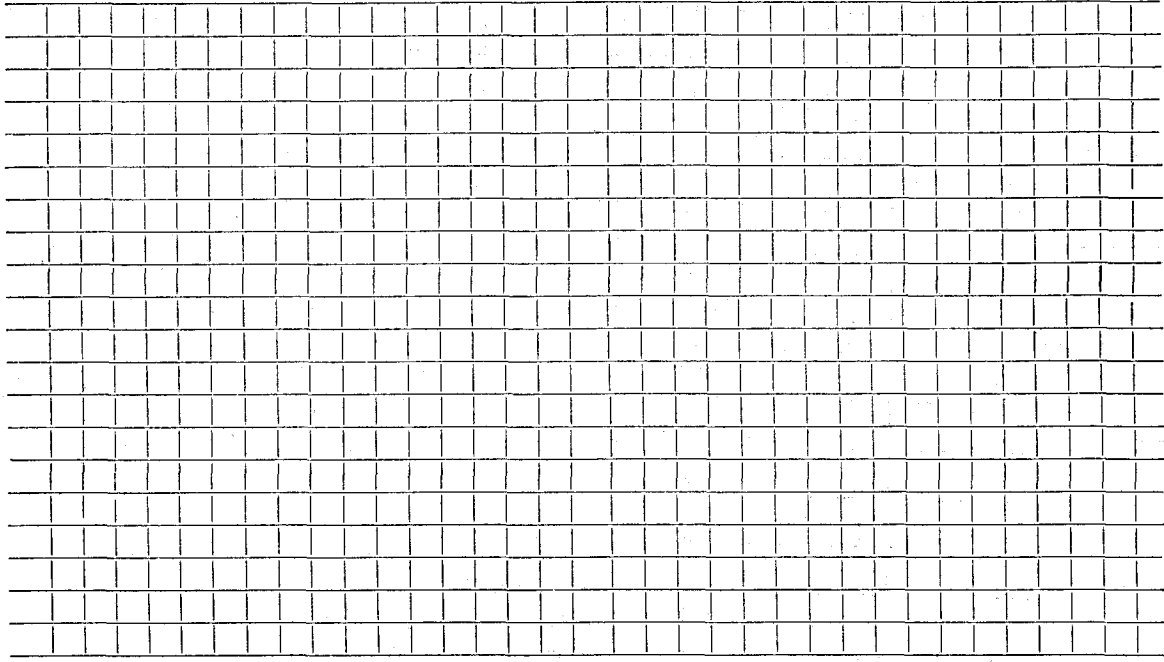

Connection made in Street. Work completed

Remarks:

.....

.....

.....