

Name Gabriel Baker

Address 14 Harding Road

Lexington, Mass.

Location 14 Harding Road

Kind of Pipe Size Location

~~XXXXXXXXXX~~ New Service Com. 12-19-19

Date	Material	Amount	Total		Date	Location	Amount
Dec. 1, '19	Labor	40 35			Nov. 28, '19	Deposited	120 00
Dec. 2, '19	Labor	9 60	49 95		Dec. 31, '19	Expended	3 48
	10% Overhead		5 00				121 52
	54' - 6" Sewer Pipe @.265		14 31				
	1 - 6" 1/8 Bend		1 52				
	Joint Compound		3 24				
	Littlefield Shovel 1/4 hrs. @ 7.00		20 00				
	Trucking 2 hrs. @.75		1 50				
	Patching 18 x 3		18 00				
			121 52				
	Labor						

TOWN OF LEXINGTON—DEPT. OF PUBLIC WORKS

SEWER DIVISION

DATE

NO.


The undersigned applies for the construction of a particular sewer connecting No.
Street and hereby agrees to comply with the Rules and Regulations governing the construction and use of Particular
Sewers, as now or at any future time established by the Board of Selectmen.

Am't of estimate \$.....

Am't Paid \$.....

..... Owner

Sketch of Service Here

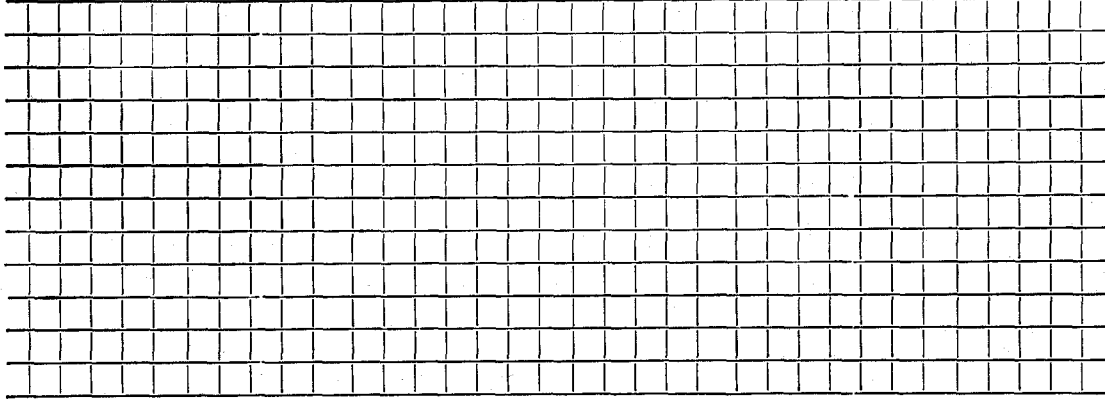

Connection made in Street.

Work completed 19..

Remarks: