

Name C. I. Lohr

Service No. 89

Address 15 Harding Road

Location 15 Harding Road

Kind of Pipe Size Size of Main

~~Repairs~~ ~~Renewal~~ - New Service *Com. 11-6-50* Location

Date	Material	Amount	Total	Date	Amount
Oct. 18 '50	Labor	9 50			
Oct. 19 '50	Labor	15 33		<i>Sept 28 50</i>	<i>125 00</i>
	10% Overhead	2 48	27 31		<i>90 69</i>
	48' - 6" Sewer Pipe		13 44		
	1 - 6" Elbow		1 56		
	Joint Compound		2 88		
	4 hrs. Littlefield Shovel		28 00		
	2 hrs. Trucking		1 50		
	Patching 16 x 3		16 00		
			90 69		
	Labor				

TOWN OF LEXINGTON—DEPT. OF PUBLIC WORKS
SEWER DIVISION

DATE

NO.


The undersigned applies for the construction of a particular sewer connecting No.
Street and hereby agrees to comply with the Rules and Regulations governing the construction and use of Particular
Sewers, as now or at any future time established by the Board of Selectmen.

Am't of estimate \$.....

Am't Paid \$.....

..... Owner

Sketch of Service Here

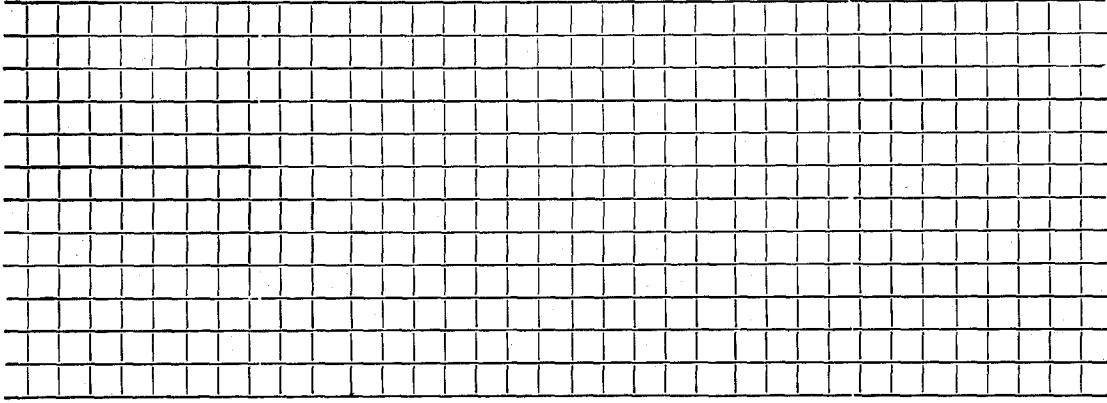

Connection made in Street.

Work completed 19..

Remarks: