

Name James J. McLaughlin

Service No. 23

Address 25 Harding Road

Location

Kind of Pipe

Size

Size of Main

REPAIR - Renewal - ~~NEW~~ W.O. #2049

Location FEB 10 1975

Date	Material	Amount	Total	Date	Amount
1/8/74	Labor	61.18		5-3-74	
	10% O.H.	6.12	67.30	5-10-75	
20'	6" Transite pipe @1.10		22.00		
1 1/2	yds. Loam @6.00		9.00		
1	4" Donut		3.05	5/8/74	
1 1/2	hr. Town Shovel @6.50		9.75	5/21/74	
1/2	hr. Town Trucking @3.00		1.50		
			112.60		
				10' 6" Transite pipe @1.10	
				1/2 bag cement	1.00
				1 1/2 yds. Loam	9.00
				2 hrs. Town Shovel @6.50	13.00
				3 3/4 hrs. Trucking @3.00	11.25
				Patch 2/x 5	8.00
					53.35

Deposit

Retard

300.00

187.40

115.60

OUTSIDE NON CHARGE


Labor 81.84

" 22.51

TOWN OF LEXINGTON — BOARD OF PUBLIC WORKS

SEWER DIVISION

Sketch of Service Here

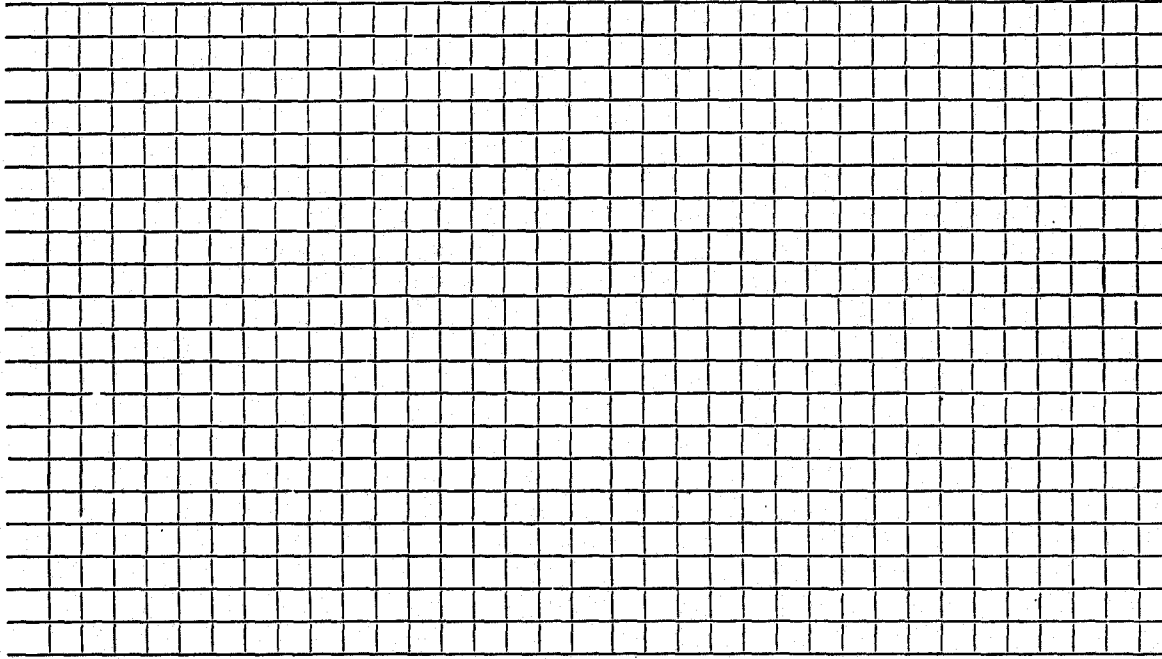

Work completed

Street

Connection made in

Remarks: Original Service 4-21-48