

Name Henry ~~Mc~~Allen

Service No.

84

1132

Address

Location 28 Harding Road

Kind of Pipe

Size

Size of Main

~~Repair~~ ~~Work~~ - New Service

Location

Date	Material	Amount	Total	Date	Amount
12/1/47	Labor	23 20		Nov. 19 47	125 00
2/2/47	Labor	22 55	45 75	Dec 31 47	22 81
	10% Overhead		4 58		102 19
	50' 6" Sewer Pipe		13 00		
	2 6" Elbows		2 36		
	Joint Compound		3 00		
	1 hr. Loader		3 00		
	2 hrs. Hired Shovel @ 7.00		14 00		
	2 hrs. Trucking		1 50		
	Patching 15x3		15 00		
	Labor		102 19		
	Conv 12/31/47				

TOWN OF LEXINGTON—DEPT. OF PUBLIC WORKS

SEWER DIVISION

DATE


The undersigned applies for the construction of a particular sewer connecting No.

Street and hereby agrees to comply with the Rules and Regulations governing the construction and use of Particular Sewers, as now or at any future time established by the Board of Selectmen.

Am't of estimate \$.....

Am't Paid \$.....

Owner

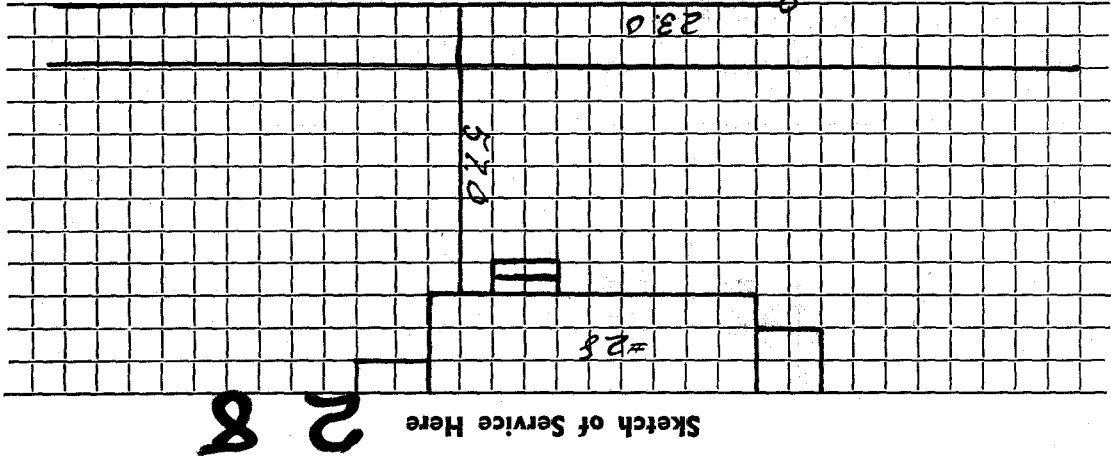

Connection made in Street.

Remarks: