

Name Arthur Leiby

Service No. 136

Address 31 Harding Road

Location 31 Harding Road

Kind of Pipe

Size

Size of Main

~~XXXXXXXXXX~~ - New Service

Com. 5/28/51

Location

Date	Material	Amount	Total	Date	Amount
2/20/51	Labor		38 40	12-27-50	125 00
	10% Overhead		3 84	8-2-51	27 45
	32 1/2" Sewer Pipe @ .344		11 01		97 55
	1-6" Elbow		1 88		
	Joint Compound		1 92		
	3 Hrs. Littlefield Shovel @ 7.		21 00		
	2 Hrs. Trucking @ .75		1 50		
	Patching 18 x 3		18 00		
			<u>97 55</u>		
	Labor				

TOWN OF LEXINGTON—DEPT. OF PUBLIC WORKS
SEWER DIVISION

DATE

The undersigned applies for the construction of a particular sewer connecting No.


Street and hereby agrees to comply with the Rules and Regulations governing the construction and use of Particular Sewers, as now or at any future time established by the Board of Selectmen.

Am't of estimate \$.....

Am't Paid \$.....

Owner

Sketch of Service Here

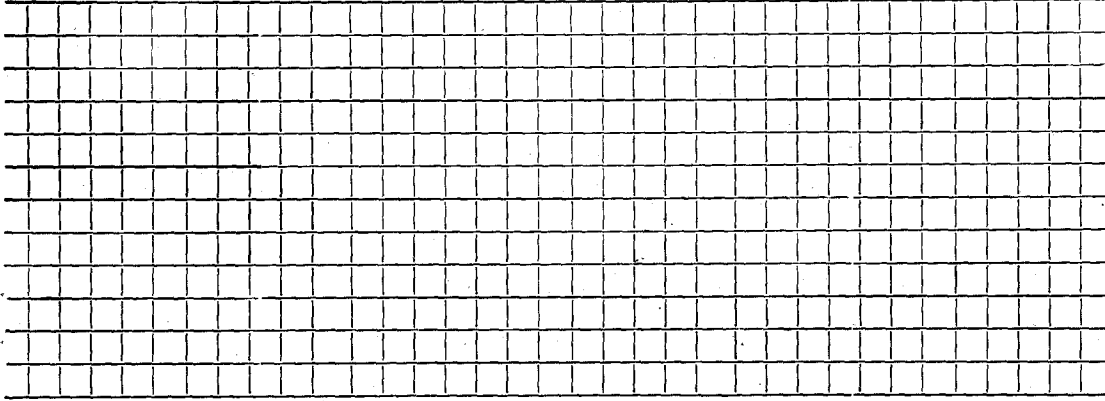

Connection made in Street. Work completed 19..

Remarks: