

Name John M. Erskine
 Address 41 Harding Road
 Lexington

Service No. 50

Location 41 Harding Road

Kind of Pipe Size Size of Main Location

~~Repair~~ Renewal—New Service

Case 116-50

Date	Material	Amount	Total	Date	Amount
Aug. 4 '50	Labor	32 97	36 27	July 21 '50	125 00
	10% Overhead	3 30	14 00		21 17
	50' - 6" Sewer Pipe @ 28¢		1 56		109 88
	1 - 6" Elbow		3 00		RENEWED BY TOWN W.O. #1975
	Joint Compound		35 00	12/1/82	6" A.C. Pipe
	5 hrs. Littlefield Shovel		1 50	1	6" x 8" Saddle
	2 hrs. Trucking		12 00	1	6" Fernco Coupling
	Patching 12 x 3		103 33	6	Ton Gravel
				3	Ton Cold Patch
					REPAIRED 06-28-90
					6' 6" PVC 2 6X6 FERNCO'S
					ROOTS ON HOMEOWNER'S PROPERTY
	Labor			12-27-76	Plugged Sewer
				11-28-71	Ports
				1-26-89	Ports at Elbow - Chimney at main
				11-8-99	Roots by chimney + by house

TOWN OF LEXINGTON—DEPT. OF PUBLIC WORKS SEWER DIVISION


The undersigned applies for the construction of a particular sewer connecting No. Street and hereby agrees to comply with the Rules and Regulations governing the construction and use of Particular Sewers, as now or at any future time established by the Board of Selectmen.

Am't of estimate \$.....
Am't Paid \$.....

PROPERTY LINE

Owner

Sketch of Service Here **41**

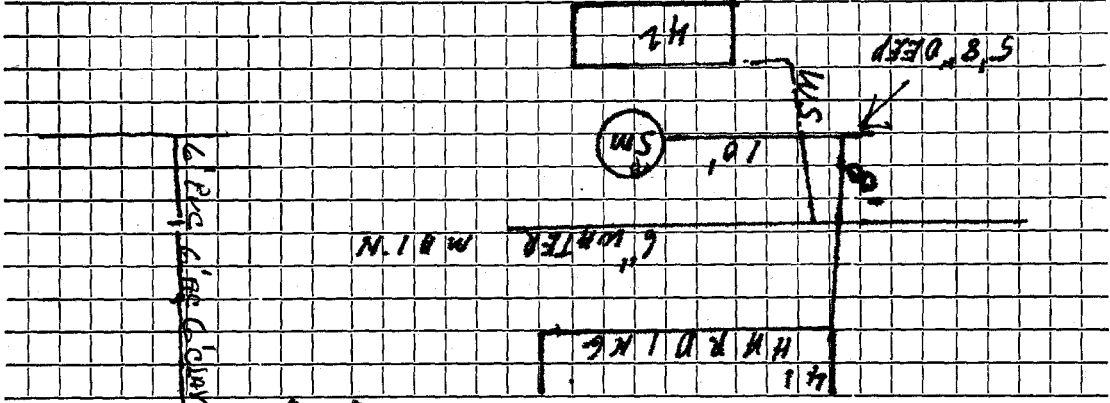

Connection made in Street. Work completed 19..

Remarks: