

Name N.Y. Bros. Trust

Service No. 200

Address # 42 Harding Road

Location

Kind of Pipe

Size

Size of Main

Repair/Renewal - New Service DeFlice Bros. # 2453 W.O. #1625

Location NOV 24 1976

Date	Material	Amount	Total	Date	Amount
12-31-73	28' - 6" ACP			12-13-73	Deposit
	10' - 4 C.I.			11-24-74	Ret. Fund
12-20-73	Labor	139.30		12-20-73	
	10% O.H.	13.93	\$153.23	25'	6" Transite
<del>25'</del>	<del>6" Transite Pipe</del>	<del>@1.10</del>	<del>27.50</del>	1	6" X 8" Saddle
1	8" X 6" Saddle		5.50		
1	6" Plug		3.60		
2	Ton 1 1/2 Stone	@1.50	3.00		
2	Ton Cold Patch	@12.20	24.40		
2	Hrs. Trucking	@3.00	6.00		
1	Hr. Pickup		1.50		
2	Hrs. Town Shovel	@6.50	13.00		
1	Hr. Loader		4.00		
			\$241.73		


TOWN OF LEXINGTON — BOARD OF PUBLIC WORKS

SEWER DIVISION

DATE \_\_\_\_\_

Sketch of Service Here

42

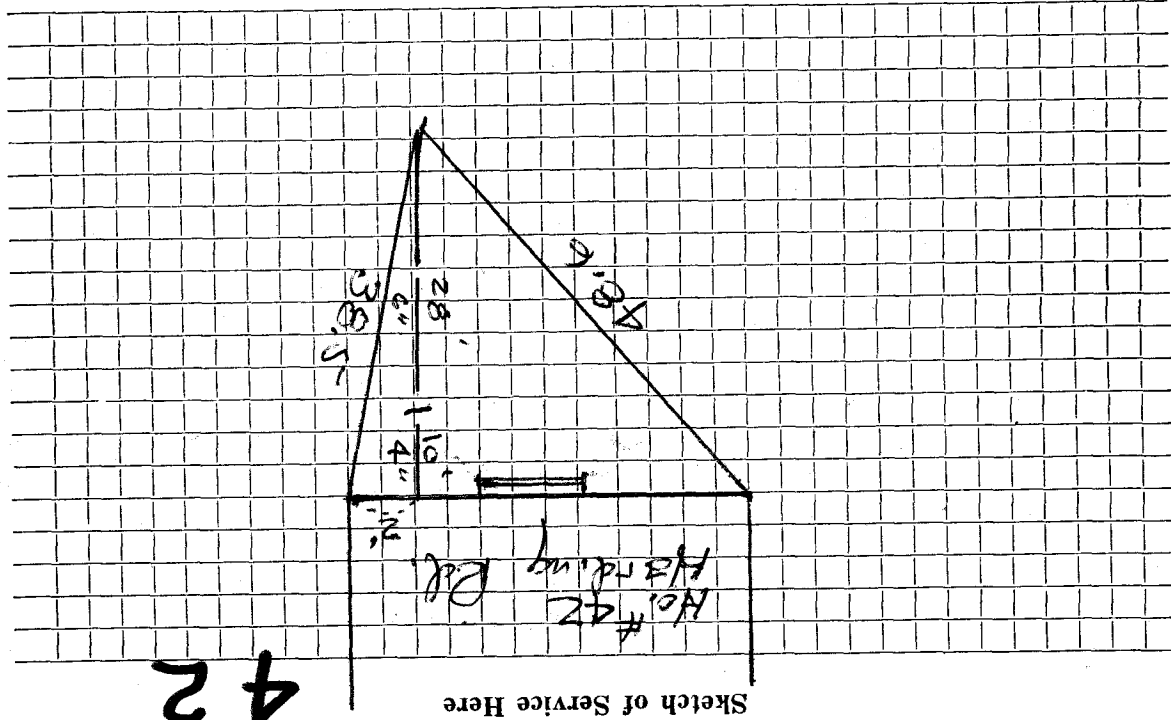

Work completed .....

Street. ....

Connection made in .....

Remarks: .....