

Name R. D. Hamilton Const. Co.

Service No. 188

Address 43 Harding Road

Location

Kind of Pipe Kirkland & Shaw

Size

Size of Main

~~REPAIR~~ - New Service

W.O. #9343 Permit #157

Location

MAY 17 1965


Date	Material	Amount	Total	Date	Amount
11-23-64	Labor	39.81		4-16-64	100.00
	10% O.H.	3.98	43.79	5-17-65	5.22
20'	6" Transite pipe @.82		16.40		94.28
1	11 1/2" Bends		4.09		
11	x 3 Patch		11.00		
2	hrs. Town Shovel @6.50		13.00		
2	hrs. Town Truck @3.00		6.00		
			94.28		

TOWN OF LEXINGTON — BOARD OF PUBLIC WORKS

SEWER DIVISION

DATE _____

Sketch of Service Here
43

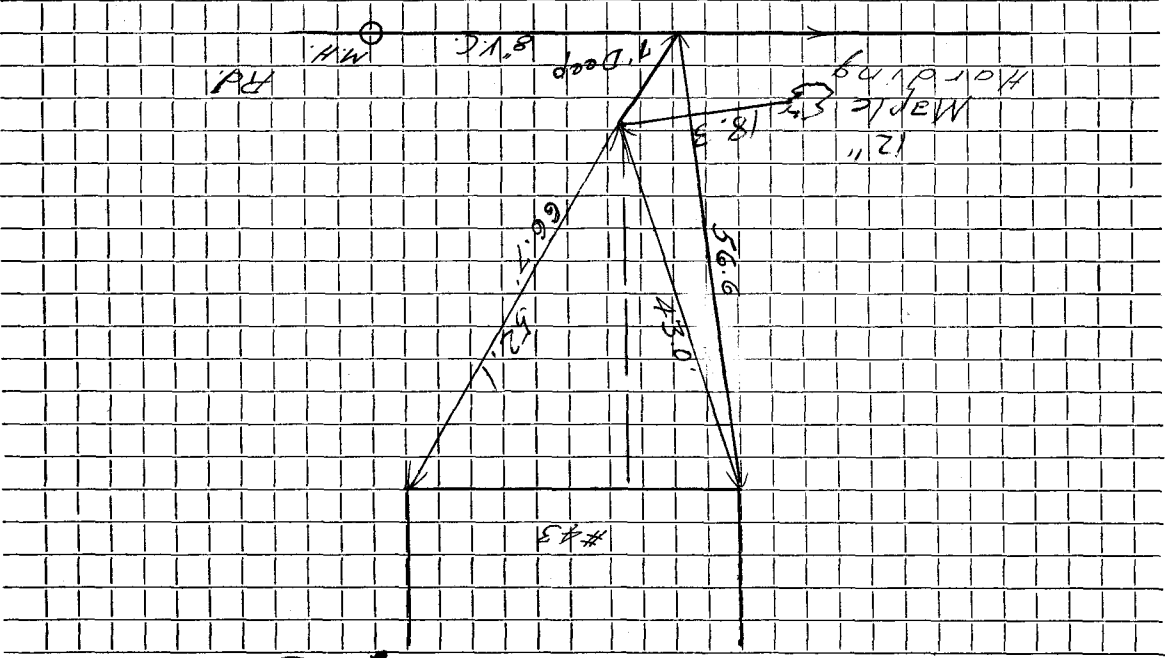

Connection made in Street. Work completed
Remarks: