

Name Grace Van Steenburgh

Service No. 5

Address 45 Harding Road

Lexington, Mass.

Location 45 Harding Road

Kind of Pipe

Size

Size of Main

~~Repair~~ ~~Renewal~~ - New Service Com. 5-2-49

Location

Date	Material	Amount	Total	Date	Amount
Mar. 18, '49	Labor	60 70		Mar. 4 '49 Deposited	125 00
Mar. 21, '49	Labor	20 46	81 16	May '49	6 25
	10% Overhead		8 12		131 25
	46' - 6" Sewer Pipe @.265		12 19		
	1 - 6" - 1/8 Bend		1 52		
	Joint Compound		2 76		
	Shovel 2 hrs. @7.00		14 00	Bull sent 5-3-49	
	Trucking 2 hrs. @.75		1 50		
	Patching 10 x 3		10 00		
			131 25		
	Labor				

**TOWN OF LEXINGTON—DEPT. OF PUBLIC WORKS
SEWER DIVISION**

DATE

The undersigned applies for the construction of a particular sewer connecting No.


Street and hereby agrees to comply with the Rules and Regulations governing the construction and use of Particular Sewers, as now or at any future time established by the Board of Selectmen.

Am't of estimate \$.....

Am't Paid \$.....

Owner

Sketch of Service Here

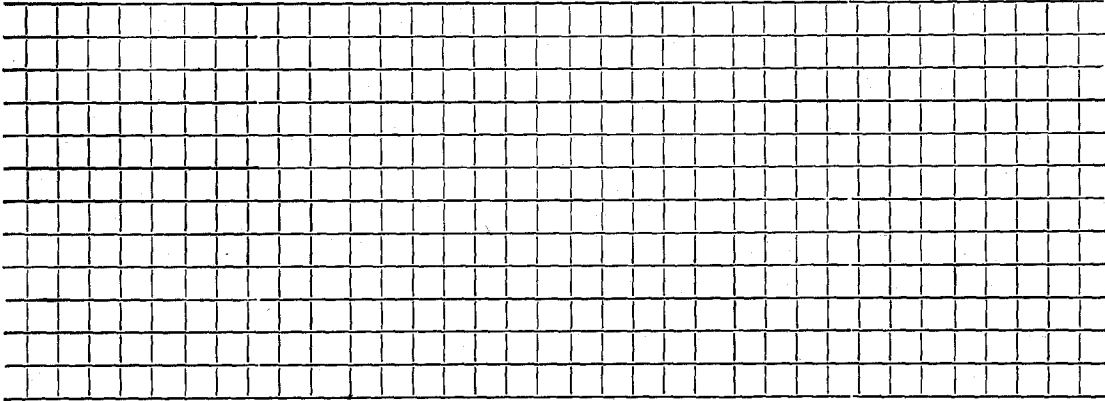

Connection made in Street. Work completed 19...
Remarks: