

Name Woodruff Broadhead

Service No. 86

1134

Address

47 Harding Road

Location 47 Harding Road

Kind of Pipe

Size

Size of Main

~~Repair~~ Renewal - New Service

Location

Date	Material	Amount	Total	Date	Amount	Amount	
12/1/47	Labor	39 23	39 23	11/20/47		125 00	
	10% Overhead		3 92	12/31/47		29 01	
	38' 6" Sewer Pipe		9 88			95 99	
	1 6" Elbow		1 18				
	Joint Compound		2 28				
	3 hrs. Hired Shovel @ 7.00		21 00				
	1 hr. Loader		3 00				
	2 hrs. Trucking		1 50				
	Patching 14x3		14 00				
			95 99				
	Labor						
	<i>Comp 12/31/47</i>						

TOWN OF LEXINGTON—DEPT. OF PUBLIC WORKS

SEWER DIVISION

DATE..... NO.....


The undersigned applies for the construction of a particular sewer connecting No. Street and hereby agrees to comply with the Rules and Regulations governing the construction and use of Particular Sewers, as now or at any future time established by the Board of Selectmen.

Am't of estimate \$.....

Am't Paid \$.....

Owner.....

Sketch of Service Here **47**

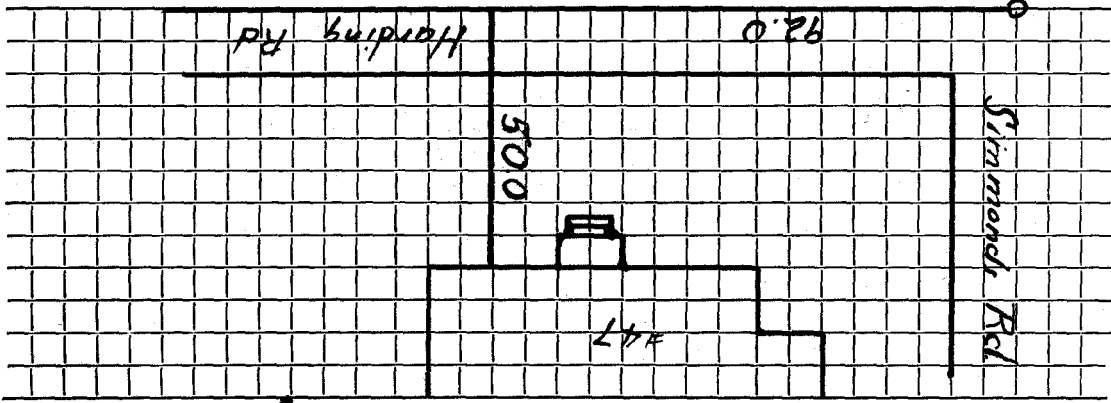

Connection made in Street. Work completed 19..

Remarks: