


TOWN OF LEXINGTON — BOARD OF PUBLIC WORKS

SEWER DIVISION

Sketch of Service Here

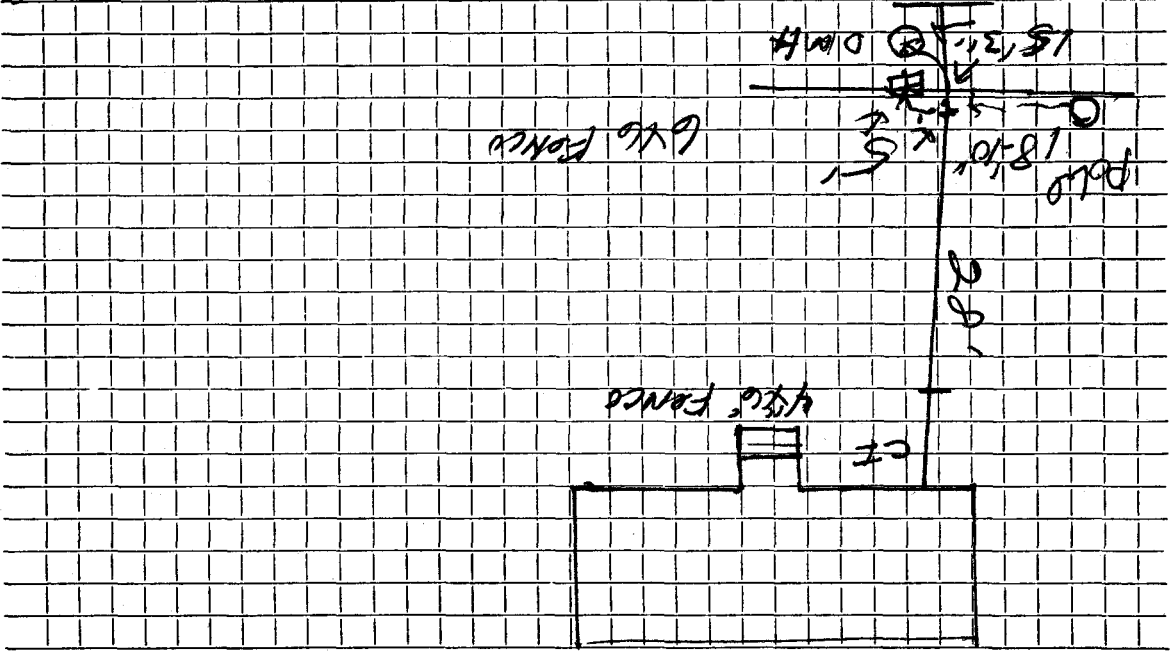

HARRIS

Connection made in

Street.

Work completed

8-14-98

BRUCE J. MCH...

Remarks:

11:10 05 REPAIR MADE

2-6" PVC to Clay Franco
7.5' - 6" PVC -

2-6" 45° Bands to get
over drain

DATE 8-14-98