

Name Clyde McArdle

Address 51 Harding Road
Lexington

Service No. 66

6-2-66

Kind of Pipe Size Location

~~XXXXXXXXXX~~ New Service COM. 6-8-53

Date	Material	Amount		Total	Date	Location	Amount
5/13/53	Labor	54	17		4-16-53	Deposited	150 -
	10% overhead	5	42	59	6-8-53	Deposited	(21 1/2
	40' - 6" sewer pipe @ .342			13			128 53
	1 - 6" elbow			1			
	joint compound			2			
	5 hrs. Littlefield shovel @ 7.50=37			50			
	2 hrs. trucking @ .75			1			
	patching 12 x 3			12			
3-23-66	Renewal			128			
12'	6" Transit			55			
1	Adapter						
1	6" - 1 1/4" Bend						
	Labor				12-15-65	ROOTS	
					12-23-66	ROOTS	

**TOWN OF LEXINGTON—DEPT. OF PUBLIC WORKS
SEWER DIVISION**


DATE.....
NO.....

The undersigned applies for the construction of a particular sewer connecting No.....
Street and hereby agrees to comply with the Rules and Regulations governing the construction and use of Particular
Sewers, as now or at any future time established by the Board of Selectmen.

Am't of estimate \$.....
Am't Paid \$.....

Owner.....

Sketch of Service Here

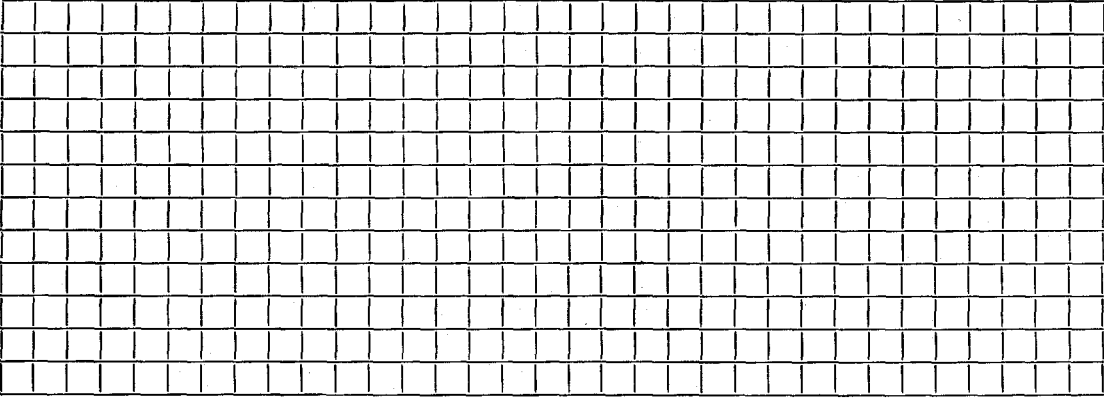

Connection made in..... Street.....
Work completed..... 19...
Remarks: