

Name Joseph J. Connors

Service No. 59

Address 54 Harding Road

Lexington

Location 54 Harding Road

Kind of Pipe

Size

Size of Main

~~Repair~~ Renewal - New Service

Com. 11-6-50

Location

Date	Material	Amount	Total		Date	Amount
Sept. 27 '50	Labor	27 31	30 04		Aug. 10 '50 <i>Adjusted</i>	125 00
	10% Overhead	2 73	14 56		Nov. 21 '50 <i>paid</i>	6 22
	52' - 6" Sewer Pipe		3 12			181 22
	Joint Compound		59 50			
	8 1/2 hrs. Littlefield Shovel		12 00		<i>Billed and 11-16-50</i>	
	4 hrs. #18 Truck		12 00			
	Patching 12 x 3		131 22			
	Labor					

TOWN OF LEXINGTON—DEPT. OF PUBLIC WORKS
SEWER DIVISION

DATE

The undersigned applies for the construction of a particular sewer connecting No.


Street and hereby agrees to comply with the Rules and Regulations governing the construction and use of Particular Sewers, as now or at any future time established by the Board of Selectmen.

Am't of estimate \$.....

Am't Paid \$.....

Owner

Sketch of Service Here

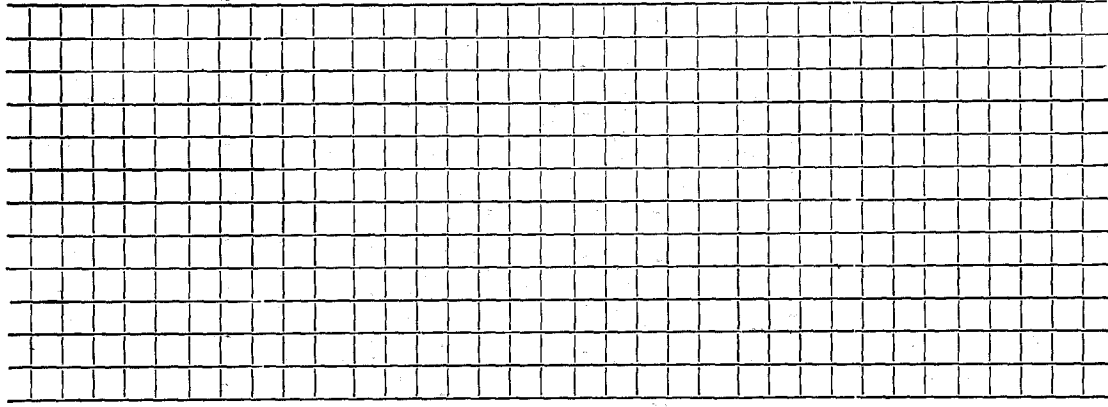

Connection made in Street. Work completed 19..

Remarks: