

Name George Walker

Address 55 Harding Road

L. xington, Mass.

Location

Kind of Pipe

Size

Size of Main

~~Repair~~ Renewal - New Service

Location

Date	Material	Amount	Total		Date	Amount
July 28, '48	Labor	20 40	20 40		July 9, '48	115 00
" 29	"	35 00	35 00		Dec. 31, '48	7 08
	10% Overhead		5 54			107 12
	50'-6" Sewer Pipe @ .26		13 00			
	1-6 x 6 y		1 18			
	1-6" Elbow		/ 50			
	Joint Compound		3 00			
	2 hrs. Littlefield Shovel		14 00			
	2 hrs. Trucking		1 50			
	Patching 12 x 3		12 00			
			<u>107 12</u>			
	Labor					

**TOWN OF LEXINGTON—DEPT. OF PUBLIC WORKS
SEWER DIVISION**

DATE

The undersigned applies for the construction of a particular sewer connecting No.


Street and hereby agrees to comply with the Rules and Regulations governing the construction and use of Particular Sewers, as now or at any future time established by the Board of Selectmen.

Am't of estimate \$.....

Am't Paid \$.....

Owner

Sketch of Service Here

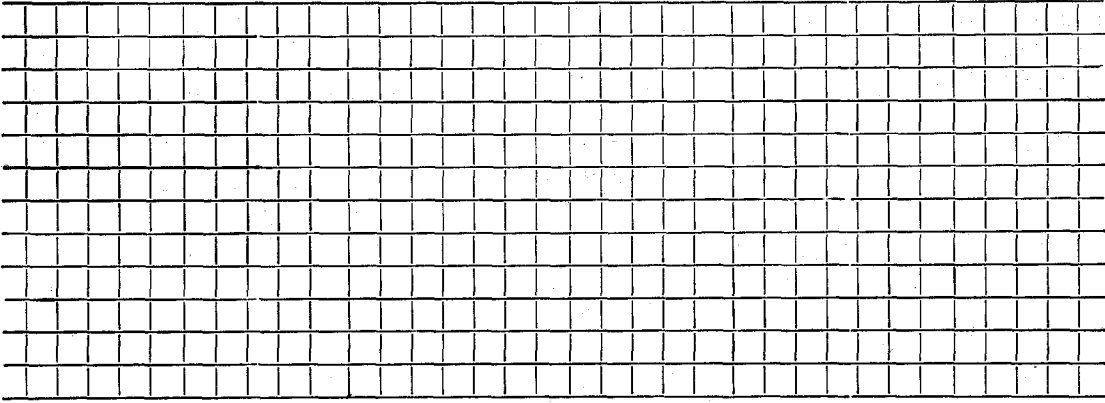

Connection made in Street. Work completed 19..

Remarks: