

65

Service No.

Name Earl R. McCaig

Address 56 Harding Road

Lexington, Mass.

Location 56 Harding Road

Kind of Pipe

Size

Size of Main

Repair ~~XXXXXX~~ ~~XXXXXX~~ ~~XXXXXX~~ - New Service

Com. 8-16-48

Location

Date	Material	Amount	Total	Date	Amount
June 23, '48	Labor	1 30		June 23 '48	125 00
24		43 00		Aug 25 '48	15 90
25		4 30	51 60		109 90
	10% Overhead		5 16		
	52' - 6" Sewer Pipe @.26		13 52		
	Joint Compound		3 12		
	Littlefield Shovel 3 hrs. @	7.00	21 00		
	Trucking 2 hrs. @.75	1 50			
	Patching 14 x 3	14 00			
			109 90		
	Labor				

TOWN OF LEXINGTON—DEPT. OF PUBLIC WORKS
SEWER DIVISION

DATE

The undersigned applies for the construction of a particular sewer connecting No.


Street and hereby agrees to comply with the Rules and Regulations governing the construction and use of Particular
Sewers, as now or at any future time established by the Board of Selectmen.

Am't of estimate \$.....

Am't Paid \$.....

Owner

Sketch of Service Here

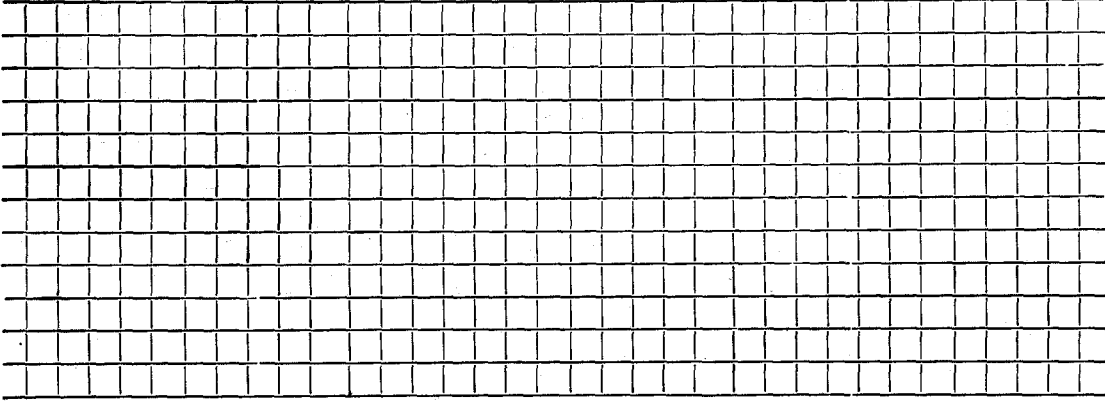

Connection made in Street. Work completed 19..

Remarks: