


DATE _____

TOWN OF LEXINGTON — BOARD OF PUBLIC WORKS

SEWER DIVISION

Sketch of Service Here

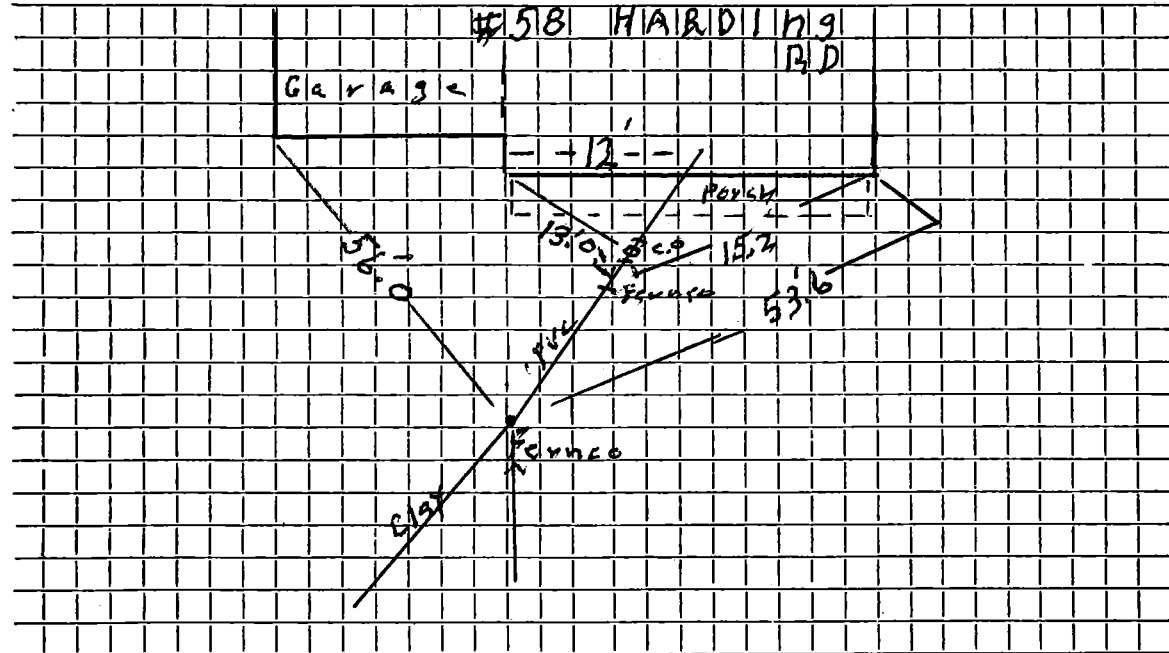

Connection made in Street. Work completed 9/26/2011 J. McLaughlin...

Remarks: 4x6 - Fence. 12" IN Front of Clean out ST. side.