

Name Ernest V. LaRose
 Address 60 Harding Road
 Lexington

Service No. 194 (1952)

COM. 3-2-53

Location

Kind of Pipe

Size

Size of Main

~~REPLACEMENT~~ New Service

Location

| Date | Material | Amount | Total | Date | Amount |
|--------|----------------------------|--------|--------------|----------|------------------|
| 2/5/53 | Labor | 50 27 | | 12-13-52 | Deposited 175 00 |
| | 10% overhead | 5 03 | 55 30 | 3-2-53 | Refunded (78 20) |
| | 60' - 6" sewer pipe @ .342 | | 20 52 | | |
| | 1 - 6" elbow | | 1 88 | | 96 80 |
| | joint compound | | 3 60 | | |
| | 2 hrs. trucking @ .75 | | 1 50 | | |
| | patching 14 x 3 | | 14 00 | | |
| | | | <u>96 80</u> | | |
| | Labor | | | | |


TOWN OF LEXINGTON—DEPT. OF PUBLIC WORKS
SEWER DIVISION

DATE.....
NO.....

The undersigned applies for the construction of a particular sewer connecting No.....
Street and hereby agrees to comply with the Rules and Regulations governing the construction and use of Particular
Sewers, as now or at any future time established by the Board of Selectmen.

Am't of estimate \$.....
Am't Paid \$.....

..... Owner

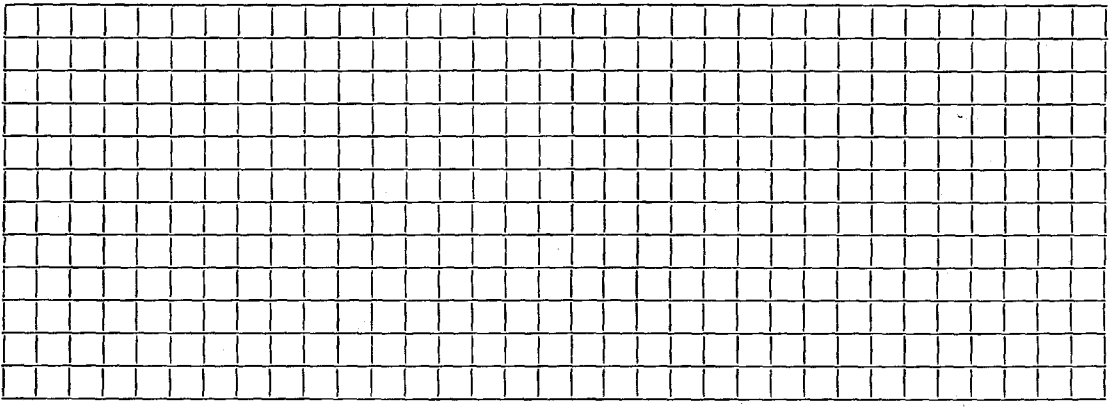

Sketch of Service Here

Connection made in..... Street.
Work completed..... 19.....
Remarks: