

Name Frances B. Culbertson

Service No. 94 1142

Address 62 Harding Road

Location 62 Harding Road

Kind of Pipe

Size

Size of Main

~~Repair~~ Renewal - New Service

Location

Date	Material	Amount	Total	Date	Amount
Dec. 22, '47	Labor	55.00		12/11/47	175.00
23	"	10.80	65.80	12/31/47	14.91
	10% Overhead		6.58		160.09
	78' - 6" Sewer Pipe		20.28		
	Joint Compound		4.68		
	Hired Shovel 8 hrs. @ 7.00		56.00		
	Compressor 3 hrs. @ 1.75		5.25		
	Trucking 1 hr. @ .75		1.50		
			160.09		
	Labor				
	<i>Crew 12/31/47</i>			9-23-65	ROOTS
				10-12-95	ROOTS OUT - 30 Feet





TOWN OF LEXINGTON—DEPT. OF PUBLIC WORKS


SEWER DIVISION

DATE ..... NO. ....

The undersigned applies for the construction of a particular sewer connecting No. .... Street and hereby agrees to comply with the Rules and Regulations governing the construction and use of Particular Sewers, as now or at any future time established by the Board of Selectmen.

Am't of estimate \$ .....  
 Am't Paid \$ .....

Owner .....

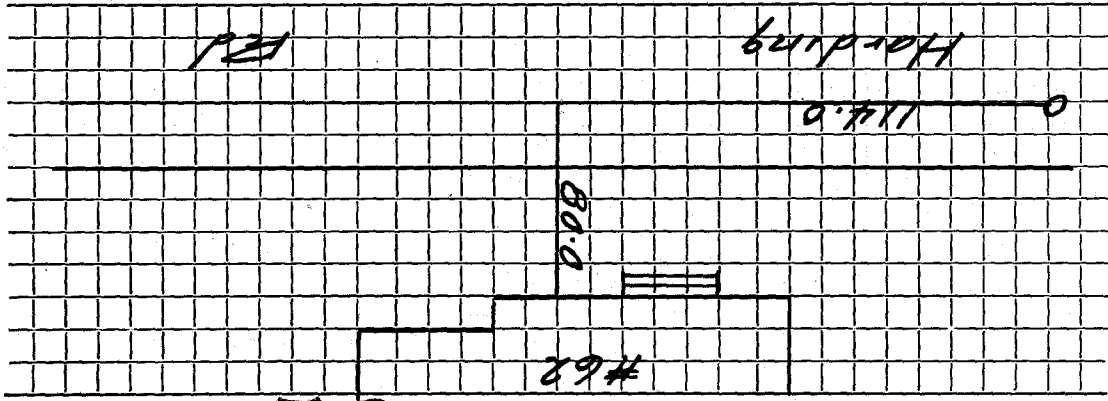

Sketch of Service Here **62**

Connection made in ..... Street. Work completed ..... 19..

Remarks: