

Name

Ernest Outthet

Service No. 225

Address

621A Harding Road

603

Location

Kind of Pipe

Size

Size of Main

Repair/Replacement - New Service

Comm. 2-20-56 Location

Date	Material	Amount	Total	Date	Amount
12-15-55	Labor	25 85		11-29-55	\$ 150 00
12-16-55	Labor	47 84		3-2-56	Paid a/c by Beyond 3 77
		73 69			153 77
	10% overhead	7 38	81 07	5-6-56	Paid 33 08
	52' 6" sewer pipe @ .49		25 48		186 85
	1 - 6" elbow		1 35		
	Joint compound		3 12		
	12x3 patching		12 00		
	7 1/3 hrs. Littlefield Sh. @ .50		62 33		
	2 hrs. trucking @ .75		1 50		
			186 85		Bill No. 12-21-56
	Labor				

**TOWN OF LEXINGTON—DEPT. OF PUBLIC WORKS
SEWER DIVISION**


DATE..... NO.....

The undersigned applies for the construction of a particular sewer connecting No.....
Street and hereby agrees to comply with the Rules and Regulations governing the construction and use of Particular
Sewers, as now or at any future time established by the Board of Selectmen.

Am't of estimate \$.....
Am't Paid \$.....

Owner.....

Sketch of Service Here

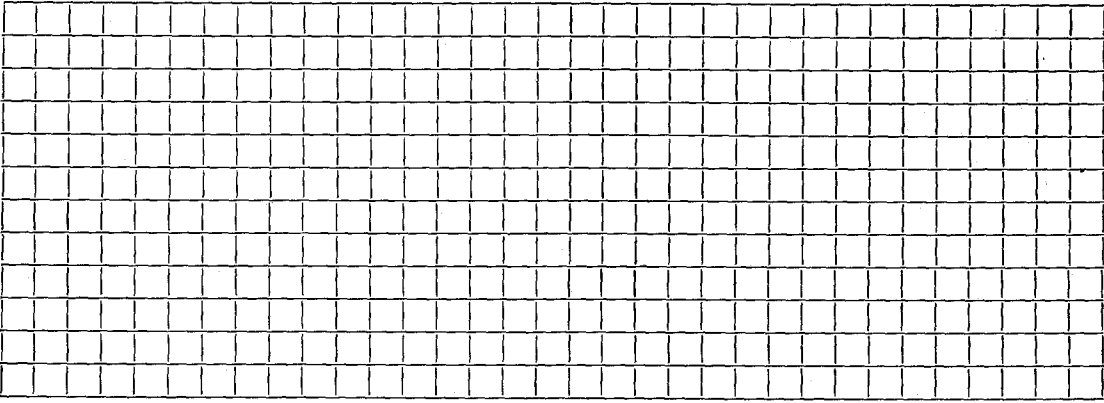

Connection made in..... Street.....
Work completed..... 19.....
Remarks: