

Name

Service No.

Address 65 Harding Rd.

Location

Kind of Pipe

Size

Size of Main

Repair—Renewal—New Service

Location


Date	Material	Amount	Total	Date	Amount
11-7-02	56' - 6" PVC				
	1-6x6" PVC to PVC	FERNCO			
	1-6x6 AC to PVC	FERNCO			
	1-22° PVC Elbow				

TOWN OF LEXINGTON — BOARD OF PUBLIC WORKS

SEWER DIVISION

DATE _____

Sketch of Service Here

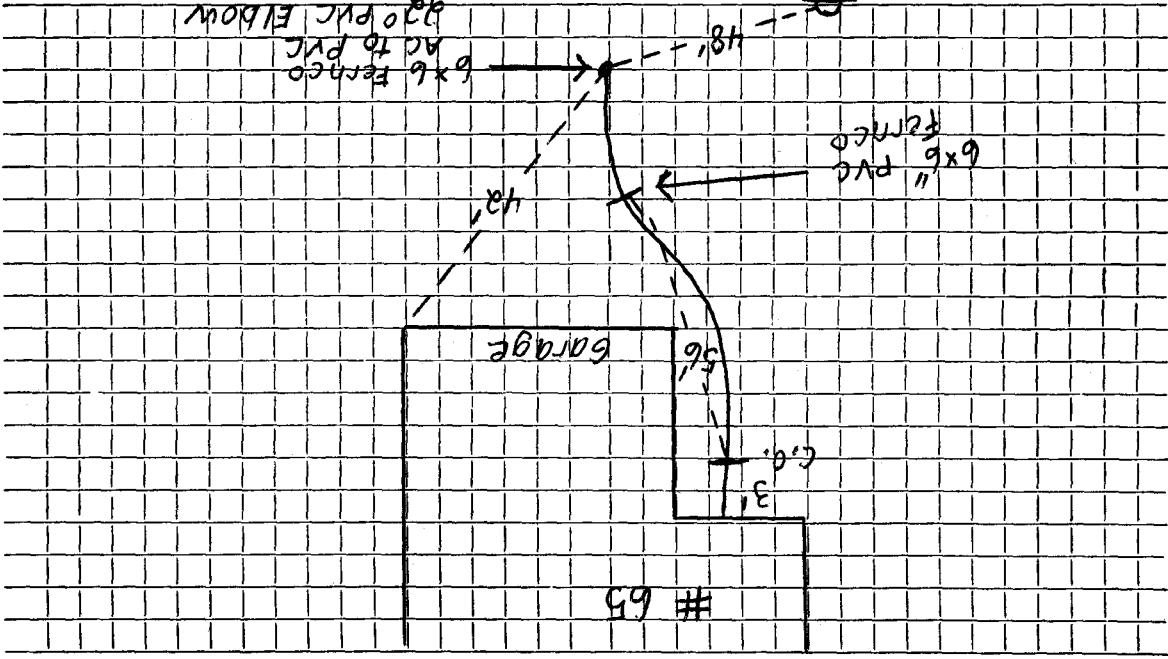

Connection made in Street. Work completed.
Remarks: