

Name Deb Homes Inc.

Service No. 62-C

Address 70 Harding Road

Location 70 Harding Road

Lexington

Kind of Pipe

Size

Size of Main

Repair ~~Renewal~~ - New Service

Comm. 11-6-50

Location

Date	Material	Amount	Total	Date	Amount
Aug. 28 '50	Labor	46 63		Aug 15 '50	125
	10% Overhead	4 66	51 29	Sept	2
	58' - 6" Sewer Pipe		16 24		122 07
	1 - 6" Elbow		1 56		
	Joint Compound		3 48		
	4 hrs. Littlefield Shovel		28 00		
	2 hrs. Trucking		1 50		
	Patching 20 x 3		20 00		
			122 07		
	Labor				

**TOWN OF LEXINGTON—DEPT. OF PUBLIC WORKS
SEWER DIVISION**

DATE NO.


The undersigned applies for the construction of a particular sewer connecting No.
Street and hereby agrees to comply with the Rules and Regulations governing the construction and use of Particular
Sewers, as now or at any future time established by the Board of Selectmen.

Am't of estimate \$.....

Am't Paid \$.....

Owner

Sketch of Service Here

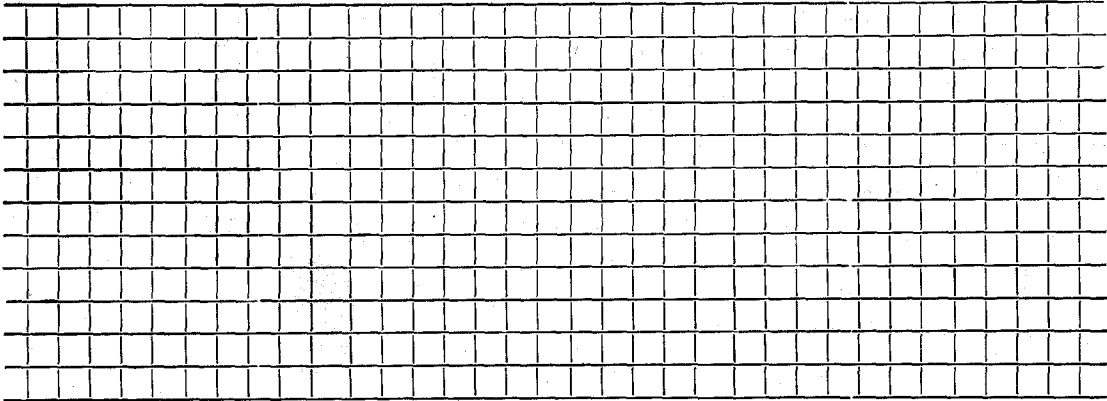

Connection made in Street. Work completed 19..

Remarks: