


SEWER DIVISION

TOWN OF LEXINGTON — BOARD OF PUBLIC WORKS

DATE

9/19/95

Sketch of Service Here

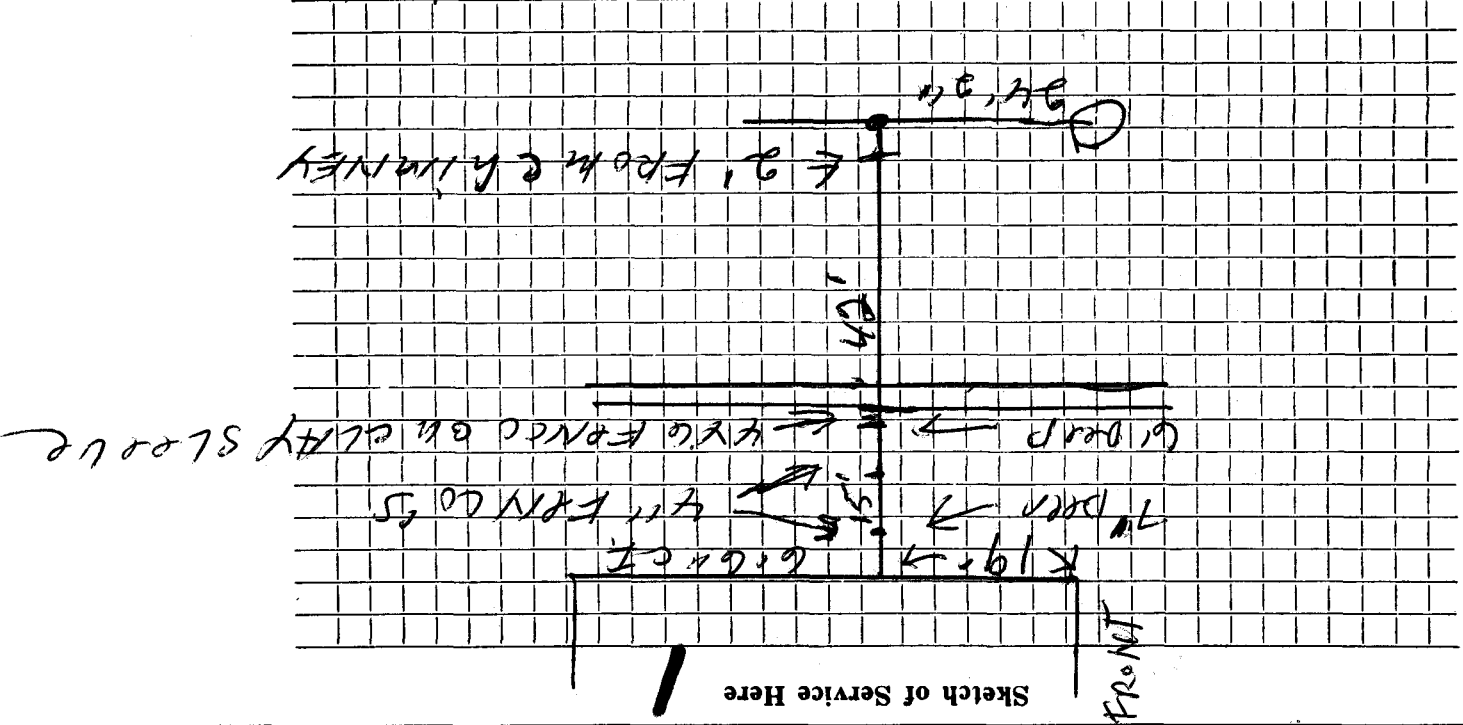

FRONT

Connection made in Street.

Bedford

4" PVC

Work completed

9/19/95

Bruce J. McKee

Remarks: