


TOWN OF LEXINGTON — BOARD OF PUBLIC WORKS

SEWER DIVISION

DATE _____

Sketch of Service Here

5

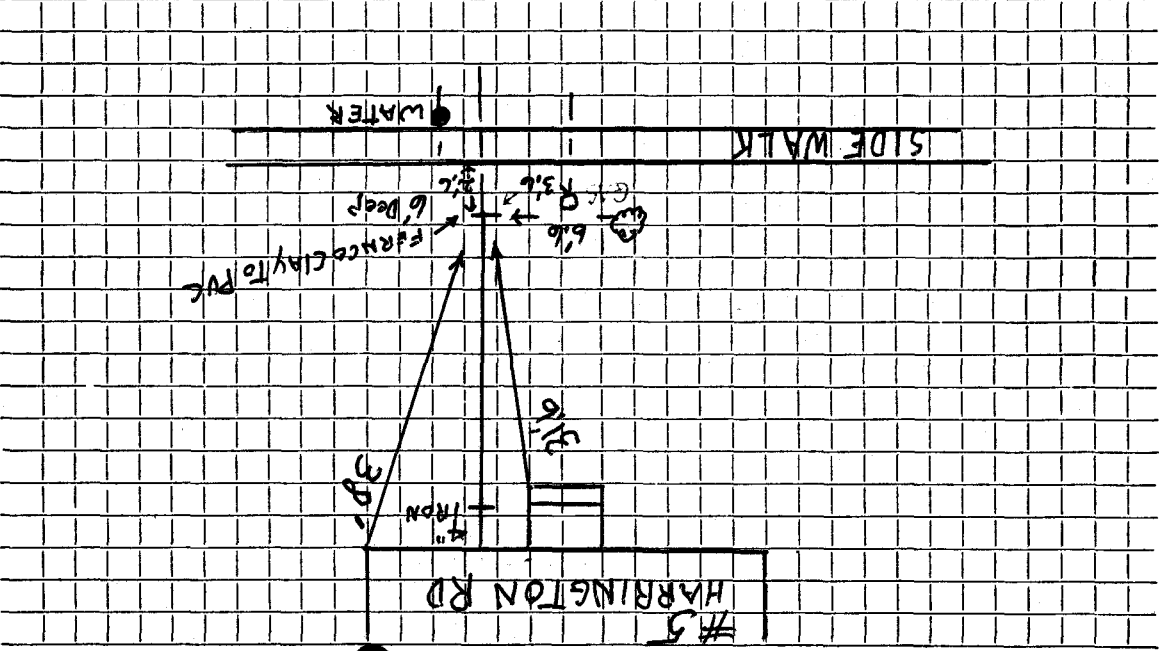

Connection made in Street. Work completed.
Remarks: Clay to PVC FERRUCO 2' 6" Behind Side Walk - small amount Roots still side use Problem Now See Densherty.