

TOWN OF LEXINGTON—BOARD OF PUBLIC WORKS
SEWER DIVISION

DATE _____

The undersigned applies for the construction of a particular sewer connecting No. 7 Harrington Rd


Street and hereby agrees to comply with the Rules and Regulations governing the construction and use of Particular

Sewers, as now or at any future time established by the Board of Selectmen.

Am't. of Estimate \$ _____

Am't. Paid \$ _____

Owner _____

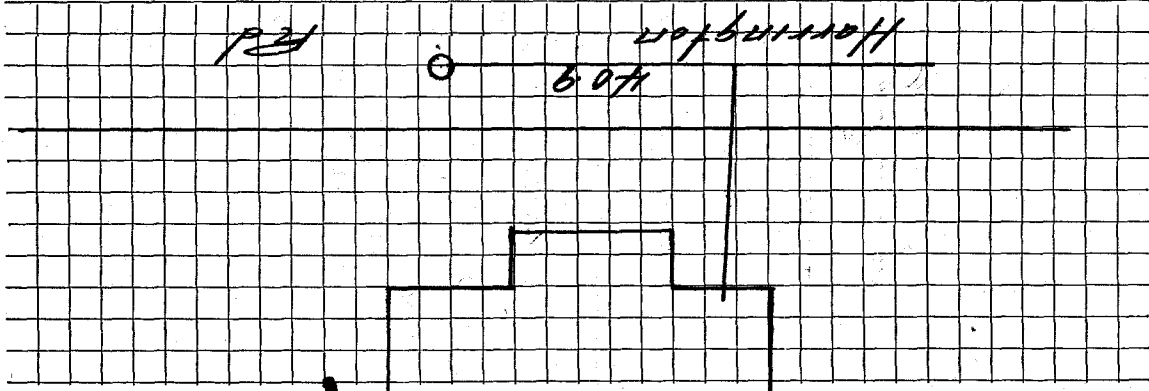

Sketch of Service Here

2

Connection made in _____

Street. _____

Work completed _____

19 _____

Remarks: _____