

Name

Service No.

Address *101 Hartwell Ave.*

Location

Kind of Pipe

Size

Size of Main

Repair—Renewal—New Service

Location

Date	Material	Amount	Total	Date	Amount
<i>8-26-70</i>					
<i>7-7-70</i>	<i>6"</i>				


TOWN OF LEXINGTON — BOARD OF PUBLIC WORKS

SEWER DIVISION

DATE _____

Sketch of Service Here

101

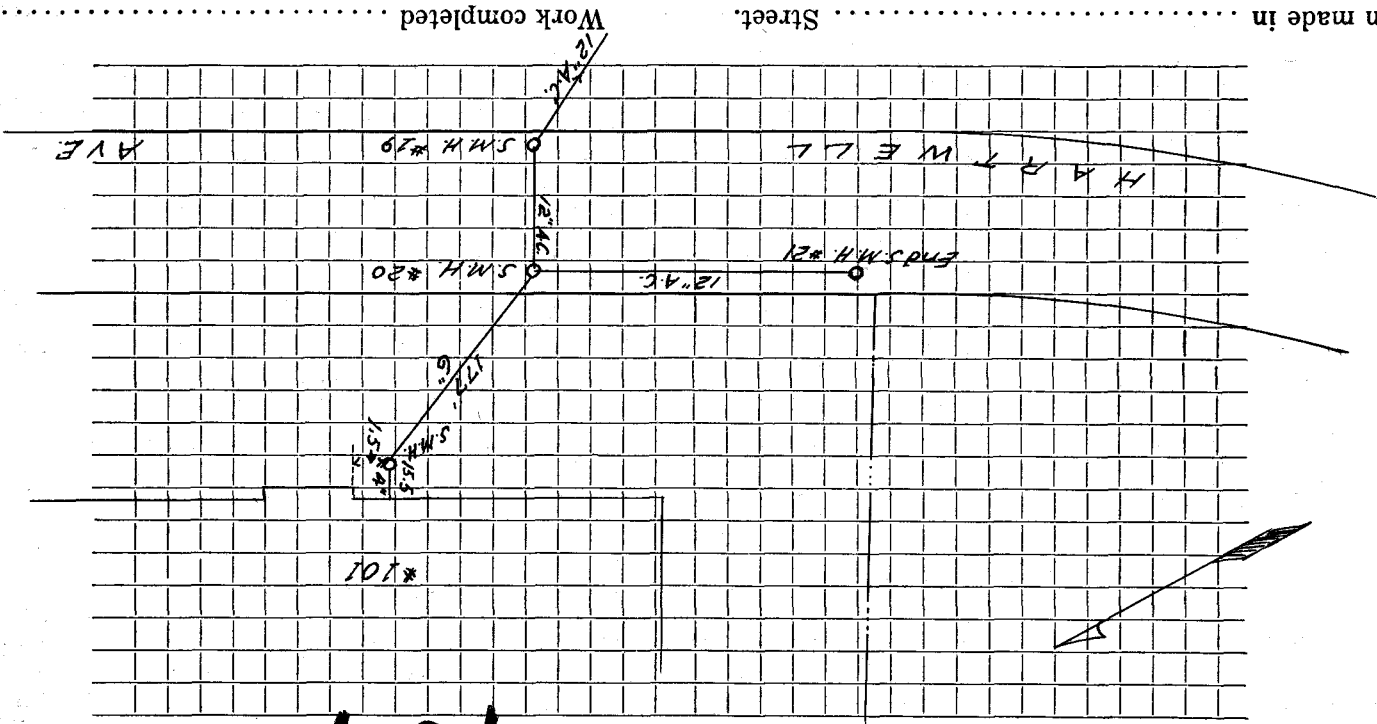

Work completed in

Street.

Connection made in

Remarks:


TOWN OF LEXINGTON — BOARD OF PUBLIC WORKS

SEWER DIVISION

DATE _____

101

Sketch of Service Here

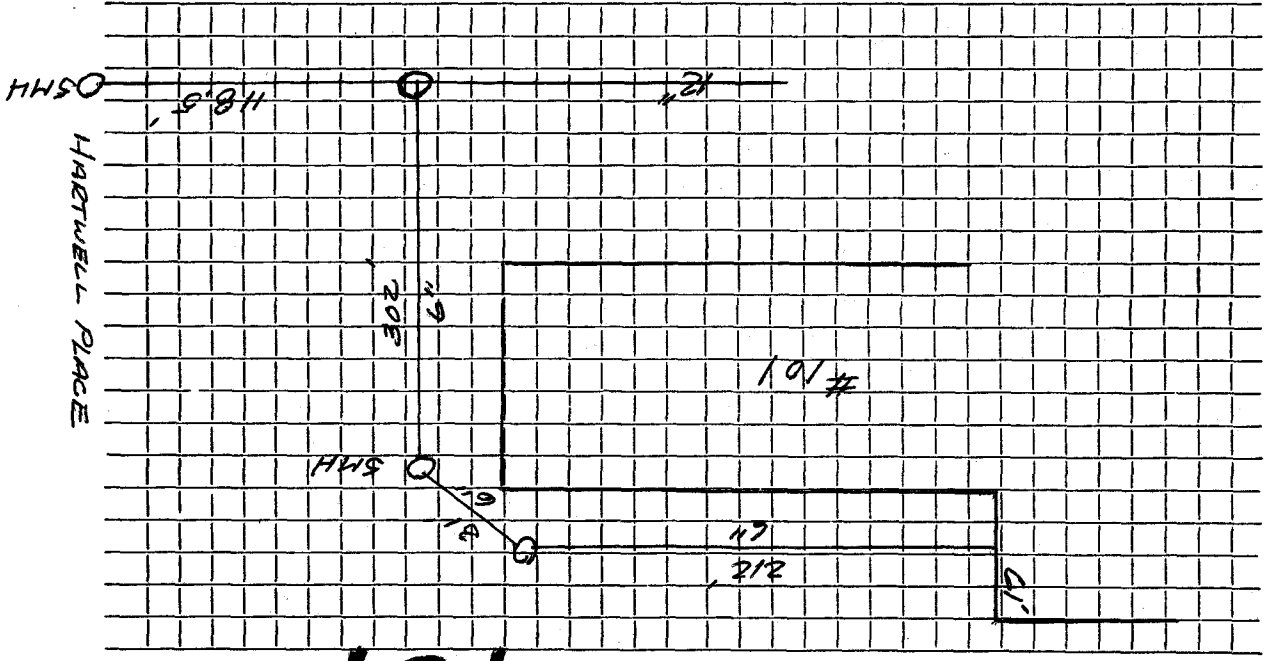

Connection made in *Haftwell* Street.

Work completed

Remarks: