


TOWN OF LEXINGTON — BOARD OF PUBLIC WORKS

SEWER DIVISION

DATE _____

Sketch of Service Here **12-18**

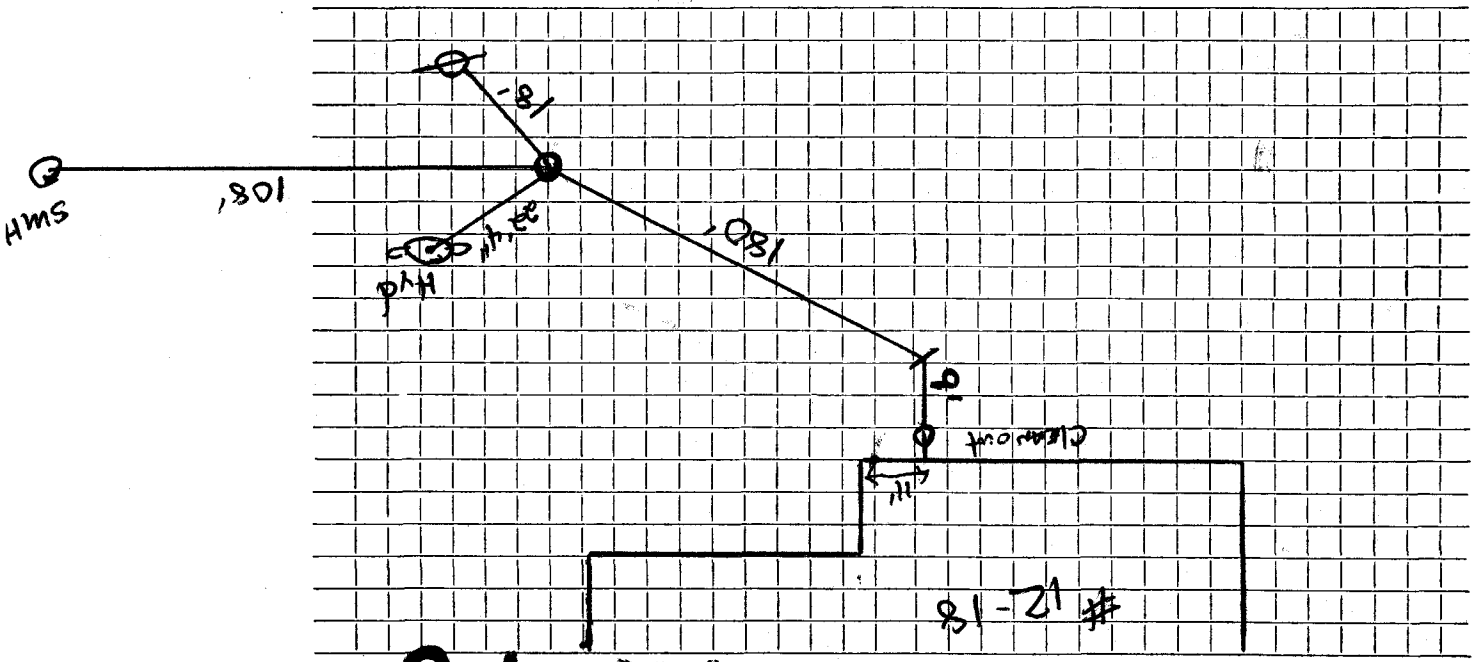

Connection made in Street. Work completed
Remarks: