




TOWN OF LEXINGTON — BOARD OF PUBLIC WORKS

SEWER DIVISION

DATE \_\_\_\_\_

Sketch of Service Here

121

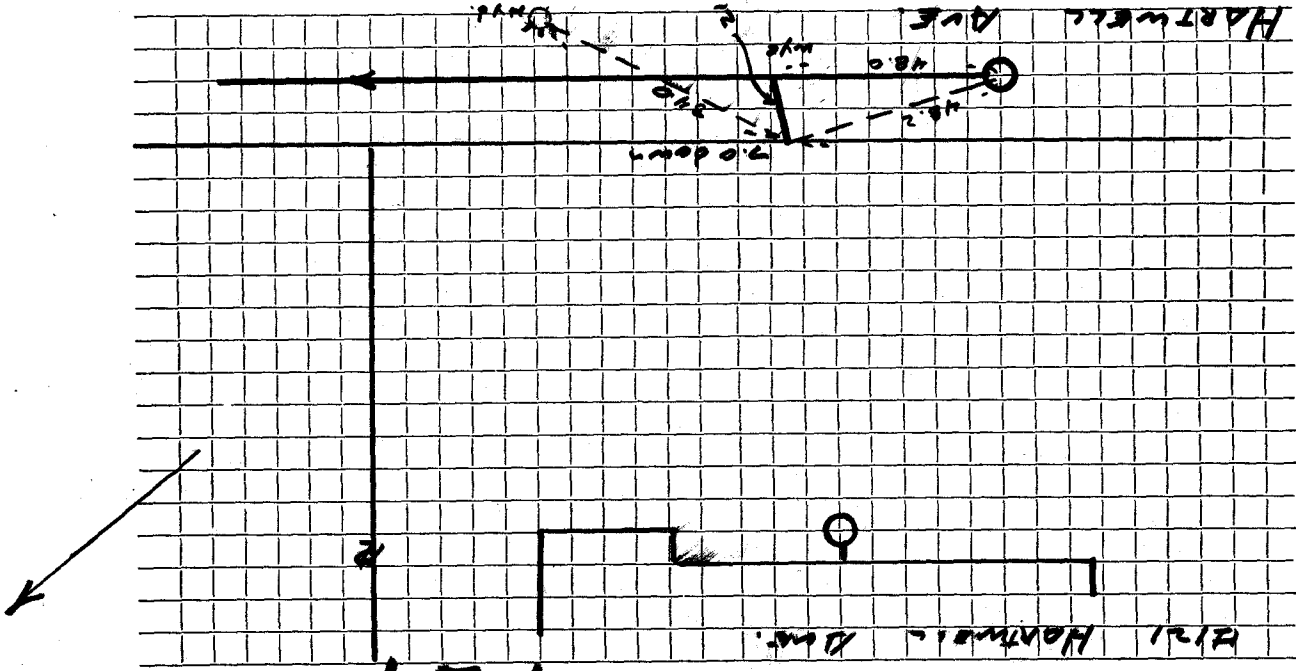

Work completed

Street.

Connection made in

Remarks: