


SEWER DIVISION

DATE _____

Sketch of Service Here **24**

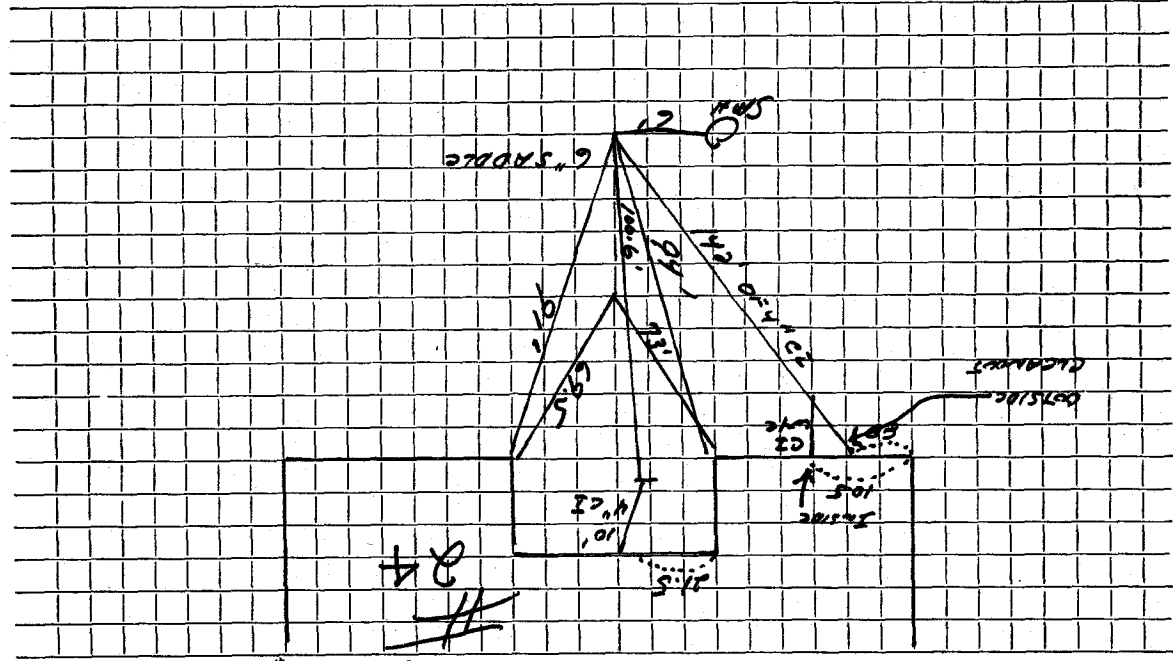

Connection made in Street. Work completed.

Remarks: