




**TOWN OF LEXINGTON — BOARD OF PUBLIC WORKS**

**SEWER DIVISION**

DATE \_\_\_\_\_

Sketch of Service Here

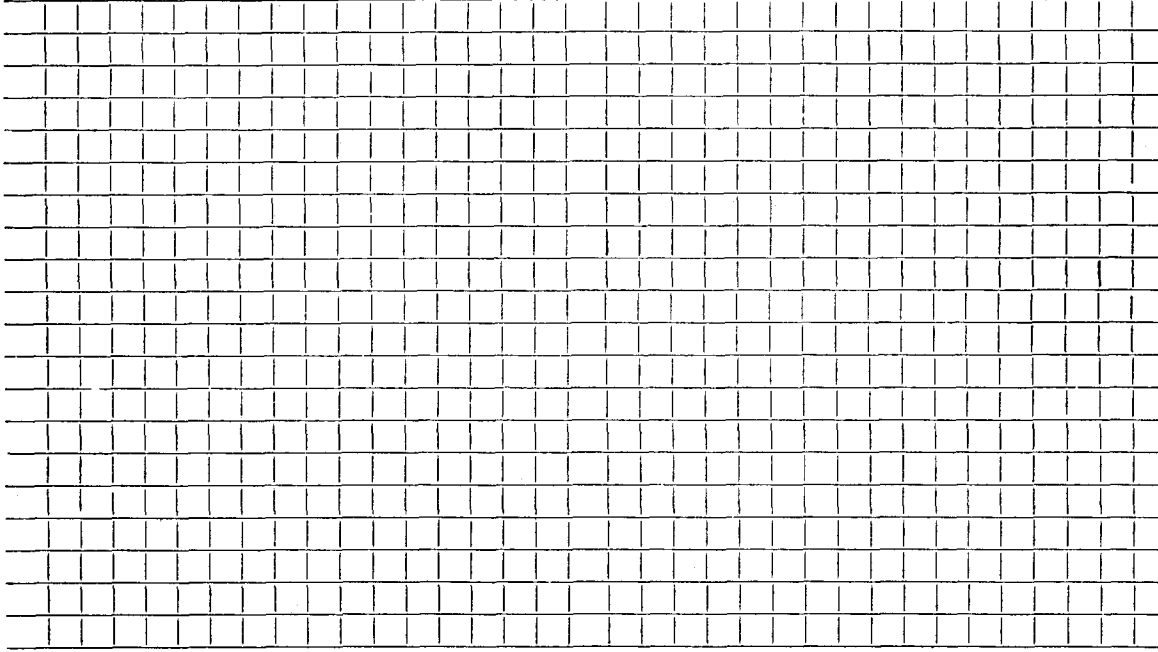

Connection made in ..... Street. Work completed .....

Remarks: .....

.....  
.....